

TATE
 F 2024
 10-3-78

MISSISSIPPI
 BOARD OF WATER COMMISSIONERS
 416 North State Street
 Jackson, Mississippi 39201

WATER WELL DRILLERS LOG

10-3-78 date well completed Hick Well Co firm name Tate county well located

LANDOWNER: Granite Farming (Rt 1)	description of formations encountered	from	to
Coldwater (mailing address)	Red Clay	0	15
WELL LOCATION: sec. 11 T. 5 N. R. 8 E 5 miles SE of Hattiesburg (distance) (direction) (nearest town)	White Sand & Clay	15	80
	White Sand	80	120
WELL PURPOSE: Home (home, irrigation, municipal, industrial)			
WELL COMPLETION DATA:			
(1) diameter (inches) 4"			
(2) total depth (feet) 120			
(3) static water level (feet) 40 below top of ground.			
(4) casing PVC, 120 (material) (depth)			
(size) If telescope see back.			
(5) screen 7' 113 (length) (depth to top)			
4" gravel type (size) (material)			
(6) pump 1/2 10 (HP) (yield gpm)			
220V (type power)			
(7) electric log No (yes or no)			
(organization running log)			
(8) how well bottom plugged Cap			
DRILLERS REMARKS:			


RECEIVED

OCT 30 1978

MISS. BD. OF WATER COM.

If well telescopes please sketch and show depths.

GROUND LEVEL

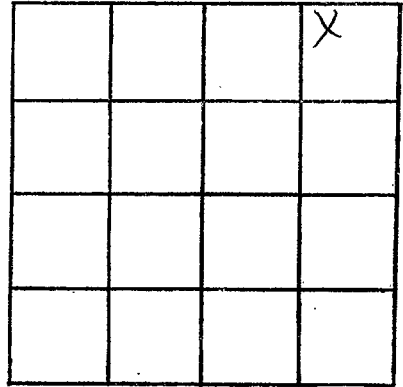

SECTION 11

Please indicate well location X.

ADDITIONAL INFORMATION

If more than one screen,
show locations of each on sketch.