

TATE
F 2025
1-05-79

**MISSISSIPPI  
BOARD OF WATER COMMISSIONERS**  
416 North State Street  
Jackson, Mississippi 39201

**WATER WELL DRILLERS LOG**


1-5-79 19 79 Hicks Well Co Tate MS  
date well completed firm name county well located

LANDOWNER: Judge Person		description of formations encountered	from	to
Ret. 2				
Senatobia, Ms. (mailing address)		Red sand	15	25
WELL LOCATION: sec. 36 T 5 N R 8 E S 2 2 miles S of Crockett (distance) (direction) (nearest town)		Gravel + sand	25	80
WELL PURPOSE: Home (home, irrigation, municipal, industrial)		White sand	80	103
WELL COMPLETION DATA:				
(1) diameter (inches) 4"				
(2) total depth (feet) 103				
(3) static water level (feet) 60 below top of ground.				
(4) casing PVC, 103 (material) (depth)				
(size) if telescope see back.				
(5) screen 7' 96' (length) (depth to top)				
4" gravel type (size) (material)				
(6) pump 1/2 10 (HP) (yield gpm)				
220V (type power)				
(7) electric log No (yes or no)				
(organization running log)				
(8) how well bottom plugged Cap				
DRILLERS REMARKS:				

**RECEIVED**  
FEB 25 1979  
Miss. Bd. OF WATER COMMISSIONERS

If well telescopes please sketch and show depths.

GROUND LEVEL

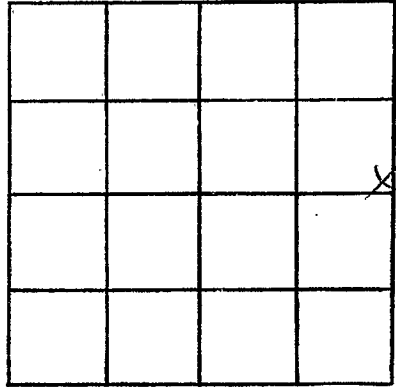

✓ SECTION 36

Please indicate well location X.

ADDITIONAL INFORMATION

If more than one screen,  
show locations of each on sketch.