

TATE
F 2026
1-12-79

MISSISSIPPI
 BOARD OF WATER COMMISSIONERS
 416 North State Street
 Jackson, Mississippi 39201

WATER WELL DRILLERS LOG

1-12-79 date well completed Hisko Well Co firm name Tate county well located

LANDOWNER: Maggie Barnes
 Rt. 4
Caldwater, Ms.
 (mailing address)

description of formations encountered	from	to
Red clay	0	15
Red sand	15	40
White sand + clay	40	120
White sand	120	155

WELL LOCATION:
 11 sec. 5 T 5 N R 8 E
5 miles NW of Somerville
 (distance) (direction) (nearest town)

WELL PURPOSE: Home
 (home, irrigation, municipal, industrial)

WELL COMPLETION DATA:

(1) diameter (inches) 4

(2) total depth (feet) 155

(3) static water level (feet) 60 below above top of ground.

(4) casing PVC, 155
 (material) (depth)
 (size) if telescope see back.

(5) screen 7', 148'
 (length) (depth to top)
4" gravel type
 (size) (material)

(6) pump 1/2, 10
 (HP) (yield gpm)

110 V
 (type power)

(7) electric log No
 (yes or no)

(organization running log)


(8) how well bottom plugged Cap

DRILLERS REMARKS:

RECEIVED
 FEB 27 1979
 MISS. BD. OF WATER COMM.

If well telescopes please sketch and show depths.

GROUND LEVEL

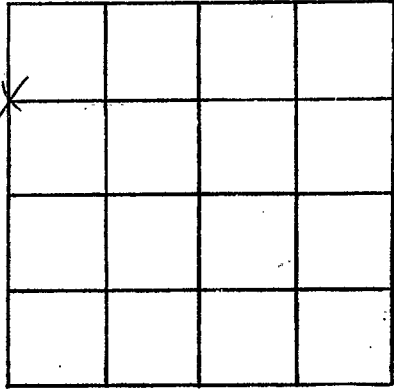

SECTION 11

Please indicate well location X.

ADDITIONAL INFORMATION

If more than one screen, show locations of each on sketch.