

TATE  
Faos  
4/13/79

MISSISSIPPI  
BOARD OF WATER COMMISSIONERS  
416 North State Street  
Jackson, Mississippi 39201

WATER WELL DRILLERS LOG

4/3 1979 Tate's Well Co. Tate  
date well completed firm name county well located

LANDOWNER:  
Tony Eddings  
Rt. 1, Coldwater, Miss 39024  
(mailing address)

description of formations encountered	from	to
Red Clay	0	20
sand	20	60
Sand + Clay	60	120
white sand	120	145

WELL LOCATION:  
sec. 11 T. 85 N R. 8 E  
3 1/2 miles NW of Sardis  
(distance) (direction) (nearest town)

WELL PURPOSE: home  
(home, irrigation, municipal, industrial)

WELL COMPLETION DATA:  
(1) diameter (inches) 4 in  
(2) total depth (feet) 145  
(3) static water level (feet) 80 below top of ground  
(4) casing Plastic, 145 ft (material) (depth)  
(size) if telescope see back.  
(5) screen 27 ft, 138 ft (length) (depth to top)  
4 in, Gravel (size) (material)  
(6) pump 1/2 HP, 10 (HP) (yield gpm)  
220 (type power)  
(7) electric log No (yes or no)  
(organization running log)  
(8) how well bottom plugged Cap.

DRILLERS REMARKS:


Miss. Board of Water Comm.

APR 9 - 1979

RECEIVED

If well telescopes please sketch and show depths.

GROUND LEVEL

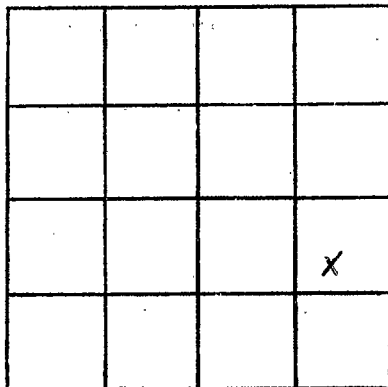

SECTION 11

Please indicate well location X.

ADDITIONAL INFORMATION

A series of horizontal lines for writing additional information, starting below the 'ADDITIONAL INFORMATION' header and extending to the bottom of the page.

If more than one screen, show locations of each on sketch.