

MISSISSIPPI DEPARTMENT OF NATURAL RESOURCES

Bureau of Land and Water Resources

Southport Mall

P.O. Box 10631

Jackson, Mississippi 39209

WATER WELL DRILLERS LOG

Date  
 F2036

9-12-80, date well completed      Bob Smith firm name      Itaw county well located

LANDOWNER:  
William C. Pace  
Coldwater Ms  
 (mailing address)

description of formations encountered	from	to
top soil	0	5
red clay	5	25
gravel	25	90
white sand	90	185

WELL LOCATION:  
 sec. 4 T 5 N R. 8 E  
S miles W of Coldwater  
 (distance) (direction) (nearest town)

WELL PURPOSE:  
 (home, irrigation, municipal, industrial)

WELL COMPLETION DATA:

(1) diameter (inches) 4"

(2) total depth (feet) 185

(3) static water level (feet) 100 below above top of ground.

(4) casing plastic, 185'  
 (material) (depth)

\_\_\_\_\_ if telescope see back.  
 (size)

(5) screen 20', 165'  
 (length) (depth to top)

4", plastic  
 (size) (material)

(6) pump 1/2 10  
 (HP) (yield gpm)

elec.  
 (type power)

(7) electric log (no)  
 (yes or no)

\_\_\_\_\_ (organization running log)

(8) how well bottom plugged cap

DRILLERS REMARKS:


DEPT. OF NATURAL RESOURCES  
 BUREAU OF LAND & WATER RESOURCES

OCT 12 1982

RECEIVED

If well telescopes please sketch and show depths.

GROUND LEVEL

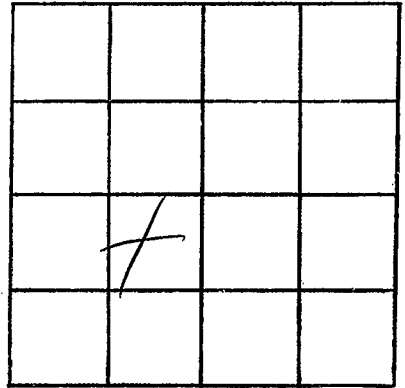

SECTION \_\_\_\_\_

Please indicate well location X.

ADDITIONAL INFORMATION

If more than one screen,  
show locations of each on sketch.