

TATE  
F 2039  
9-11-80

**MISSISSIPPI**  
**BOARD OF WATER COMMISSIONERS**  
416 North State Street  
Jackson, Mississippi 39201

**WATER WELL DRILLERS LOG**

9-11-1980     Slacks Well Co.     Tates  
date well completed     firm name     county well located

LANDOWNER:	description of formations encountered	from	to
Brewer Development	Red Clay	0	20
Senatobia, Ms. (mailing address)	Shovel	20	70
<b>WELL LOCATION:</b> sec. 25 T 5 N R 8 E S                W 1 miles W of Senatobia (distance) (direction) (nearest town)	White sand	70	153
<b>WELL PURPOSE:</b> Suburban (home, irrigation, municipal, industrial)			
<b>WELL COMPLETION DATA:</b>			
(1) diameter (inches) 4"			
(2) total depth (feet) 155			
(3) static water level (feet) 80 below top of ground.			
(4) casing PVC 155 (material) (depth)			
if telescope see back. (size)			
(5) screen 17' 148 (length) (depth to top)			
4" gravel type (size) (material)			
(6) pump 1/2 10 (HP) (yield gpm)			
22.0V (type power)			
(7) electric log No (yes or no)			
(organization running log)			
(8) how well bottom plugged Cap			

DEPT. OF NATURAL RESOURCES  
BUREAU OF LAND & WATER RESOURCES


DRILLERS REMARKS:

SEP 29 1980

**RECEIVED**

If well telescopes please sketch and show depths.

GROUND LEVEL

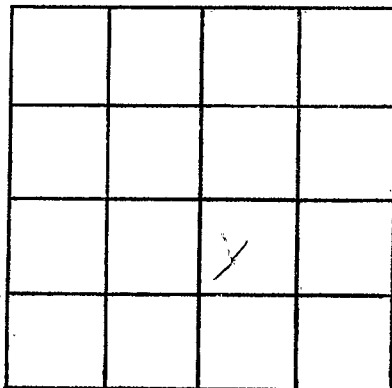

SECTION 25

Please indicate well location X.

ADDITIONAL INFORMATION

If more than one screen,  
show locations of each on sketch.