

MISSISSIPPI DEPARTMENT OF NATURAL RESOURCES

Bureau of Land and Water Resources

Southport Mall

P.O. Box 10631

Jackson, Mississippi 39209

WATER WELL DRILLERS LOG

TATE
 F 2040
 12-9-80

12-9-1980 date well completed
 SR Hecks Well Co. firm name
 Tate county well located

LANDOWNER: Charles Wickline
Merryhill Ranch Rd.
Senatobia, Mo.
 (mailing address)

description of formations encountered	depth	
	from	to
Red clay	0	20
Gravel	20	35

WELL LOCATION:
 sec. 24 T 5 N R 8 E
 (S) (SW)
2 miles NW of Senatobia
 (distance) (direction) (nearest town)

Red sand	35	60
White sand	60	115

WELL PURPOSE: None
 (home, irrigation, municipal, industrial)

WELL COMPLETION DATA:

(1) diameter (inches) 4

(2) total depth (feet) 115

(3) static water level (feet) 60 below above top of ground.

(4) casing PVC 115
 (material) (depth)

 if telescope see back.
 (size)

(5) screen 7' 108
 (length) (depth to top)

32 gravel 108
 (size) (material) (depth)

(6) pump 1/2 10
 (HP) (yield gpm)

220V
 (type power)

(7) electric log No
 (yes or no)

(organization running log)
Cap


(8) how well bottom plugged

DRILLERS REMARKS:

MISSISSIPPI DEPARTMENT OF NATURAL RESOURCES
 BUREAU OF LAND AND WATER RESOURCES
 RECEIVED
 DEC 23 1980

If well telescopes please sketch and show depths.

GROUND LEVEL

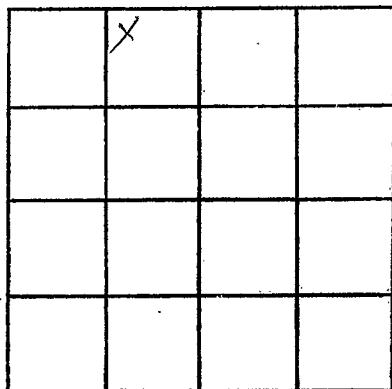

SECTION 24

Please indicate well location X.

ADDITIONAL INFORMATION

If more than one screen,
show locations of each on sketch.