

MISSISSIPPI DEPARTMENT OF NATURAL RESOURCES
 Bureau of Land and Water Resources
 Southport Mall
 P.O. Box 10631
 Jackson, Mississippi 39209
WATER WELL DRILLERS LOG

Date
F 2044

6-7 1983
 date well completed

HICKS WELL CO
 well drillers

Tate
 county well located

LANDOWNER: Dr. William Alfred
P.O. Box
Senatobia, Miss. 38668
 (mailing address)

description of formations encountered	from	to
<u>Red Clay</u>	<u>0</u>	<u>15</u>
<u>Shale</u>	<u>15</u>	<u>55</u>
<u>Beauvelt White clay</u>	<u>55</u>	<u>110</u>
<u>White sand</u>	<u>110</u>	<u>155</u>

WELL LOCATION:
 sec 25 T 5 N R 8 E
1/2 miles W of Senatobia
 (distance) (direction) (nearest town)

WELL PURPOSE: Home
 (home, irrigation, municipal, industrial)

- WELL COMPLETION DATA:
- (1) diameter (inches) 4
 - (2) total depth (feet) 155
 - (3) static water level (feet) 100 ^{below} above top of ground.
 - (4) casing PVC, 155,
 (material) (depth)
4" if telescope see back.
 (size)
 - (5) screen 10', 145'
 (length) (depth to top)
3/8", PVC
 (size) (material)
 - (6) pump 1/2, 10
 (HP) (yield gpm)
220V
 (type power)
 - (7) electric log no
 (yes or no)
 - (8) how well bottom plugged Cap
 (organization running log)

DRILLERS REMARKS:


DEPT. OF NATURAL RESOURCES
 BUREAU OF LAND & WATER RESOURCES

JUN 27 1983

RECEIVED

If well telescopes please sketch and show depths.

GROUND LEVEL

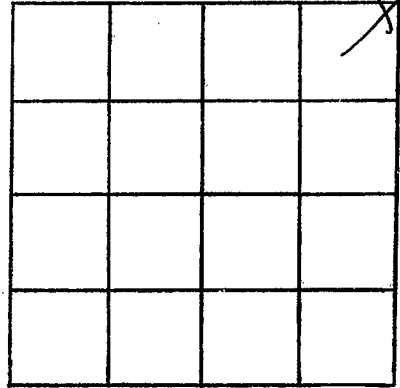

SECTION 25

Please indicate well location X.

ADDITIONAL INFORMATION

If more than one screen,
show locations of each on sketch.