

MISSISSIPPI DEPARTMENT OF NATURAL RESOURCES

Bureau of Land and Water Resources

Southport Mall

P.O. Box 10631

Jackson, Mississippi 39209

WATER WELL DRILLERS LOG

Date
 F 2043

8-8 19 83
 date well completed

HICKS WELL CO.

729 N. Hwy 157
 Senatobia MS 38660

Tate
 county well located

LANDOWNER: <u>Buddy Bucar</u>	description of formations encountered	from	to
<u>Box 2</u>			
<u>Senatobia, Ms. 38668</u> (mailing address)	<u>Red clay</u>	<u>0</u>	<u>15</u>
	<u>Red sand</u>	<u>15</u>	<u>65</u>
	<u>White sand</u>	<u>65</u>	<u>100</u>
WELL LOCATION:			
sec <u>24</u> T <u>5</u> N R <u>8</u> E <small>(distance) (direction) (nearest town)</small>			
<u>1</u> miles <u>NW</u> of <u>Senatobia</u>			
WELL PURPOSE: <u>Home</u> (home, irrigation, municipal, industrial)			
WELL COMPLETION DATA:			
(1) diameter (inches) <u>4</u>			
(2) total depth (feet) <u>100</u>			
(3) static water level (feet) <u>60</u> ^{below} above top of ground.			
(4) casing <u>PVC</u> <u>100</u> (material) (depth)			
<u>4"</u> (size) if telescope see back.			
(5) screen <u>10'</u> <u>90'</u> (length) (depth to top)			
<u>.013</u> <u>PVC</u> (size) (material)			
(6) pump <u>1/2</u> <u>10</u> (HP) (yield gpm)			
<u>220V</u> (type power)			
(7) electric log <u>No</u> (yes or no)			
(organization running log)			
(8) how well bottom plugged <u>Cap</u>			

DEPT. OF NATURAL RESOURCES
 BUREAU OF LAND & WATER RESOURCES


AUG 15 1983

RECEIVED

DRILLERS REMARKS:

If well telescopes please sketch and show depths.

GROUND LEVEL

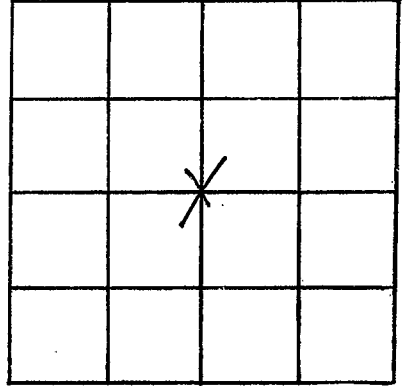

SECTION 24

Please indicate well location X.

ADDITIONAL INFORMATION

If more than one screen, show locations of each on sketch.