

MISSISSIPPI DEPARTMENT OF NATURAL RESOURCES

Bureau of Land and Water Resources

Southport Mall

P.O. Box 10631

Jackson, Mississippi 39209

WATER WELL DRILLERS LOG

HICKS WELL CO.
Rt. 1, Box 157

Senatobia, MS 38666

Date

9-28 19 83
 date well completed

Tate
 county well located

LANDOWNER: Bill Hunt
P.O. Box 84
Coldwater, Ms. 38618
 (mailing address)

description of formations encountered	from	to
Red Clay	0	10
Red Sand	10	80
Gravel	80	110
White Clay	110	125
White Clay + Sand	125	155
White Sand	155	170

WELL LOCATION:
 sec. 4 T. 5 N. R. 8 E.
4 1/2 miles W of Coldwater
 (distance) (direction) (nearest town)

WELL PURPOSE: Home
 (home, irrigation, municipal, industrial)

- WELL COMPLETION DATA:
- (1) diameter (inches) 4
 - (2) total depth (feet) 170
 - (3) static water level (feet) 120 ^{below} above top of ground.
 - (4) casing PVC, 170,
 (material) (depth)
4" if telescope see back.
 (size)
 - (5) screen 10', 160'
 (length) (depth to top)
1013, PVC
 (size) (material)
 - (6) pump 1/2, 10
 (HP) (yield gpm)
220V
 (type power)
 - (7) electric log No
 (yes or no)

 (organization running log)
 - (8) how well bottom plugged Cap


DRILLERS REMARKS:

DEPT. OF NATURAL RESOURCES
 BUREAU OF LAND & WATER RESOURCES

OCT 13 1983
 RECEIVED

If well telescopes please sketch and show depths.

GROUND LEVEL

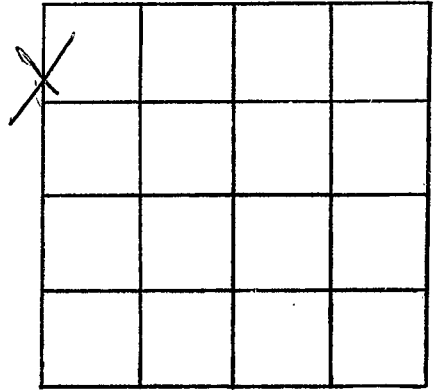

SECTION 4

Please indicate well location X.

ADDITIONAL INFORMATION

If more than one screen, show locations of each on sketch.