

MISSISSIPPI DEPARTMENT OF NATURAL RESOURCES

Bureau of Land and Water Resources

Southport Mall

P.O. Box 10631

Jackson, Mississippi 39209

WATER WELL DRILLERS LOG

Date  
 \_\_\_\_\_  
 \_\_\_\_\_  
 \_\_\_\_\_  
 \_\_\_\_\_

9-29 1983  
 date well completed

HICKS WELL CO.  
 Rt. 1 Box 20  
 Senatobia, MS 38660

Tate  
 county well located

LANDOWNER: Debra Fungy  
 Rt. 1 Box 20  
 Coldwater, Ms. 38618  
 (mailing address)

description of formations encountered	from to	
Red clay	0	35
White Sand	35	138

WELL LOCATION:  
 sec. 2 T 5 N R 8 E  
2 miles W of Coldwater  
 (distance) (direction) (nearest town)

WELL PURPOSE: Home  
 (home, irrigation, municipal, industrial)

- WELL COMPLETION DATA:
- (1) diameter (inches) 4
  - (2) total depth (feet) 130
  - (3) static water level (feet) 40 <sup>below</sup> <sub>above</sub> top of ground.
  - (4) casing PVC, 130,  
 (material) (depth)  
4"  
 (size) If telescope see back.
  - (5) screen 10', 120'  
 (length) (depth to top)  
1013, PVC  
 (size) (material)
  - (6) pump 1/2 10  
 (HP) (yield gpm)  
220V  
 (type power)
  - (7) electric log No  
 (yes or no)
  - (8) how well bottom plugged Cap

DRILLERS REMARKS:  
 \_\_\_\_\_  
 \_\_\_\_\_


DEPT. OF NATURAL RESOURCES  
 BUREAU OF LAND & WATER RESOURCES

OCT 13 1983

RECEIVED

If well telescopes please sketch and show depths.

GROUND LEVEL

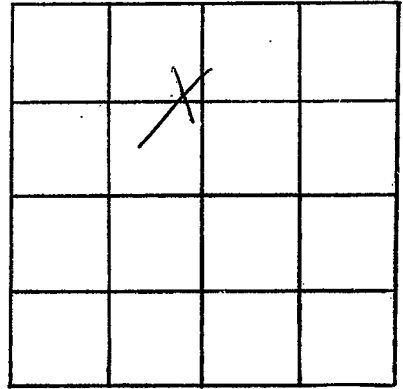

SECTION 2

Please indicate well location X.

ADDITIONAL INFORMATION

If more than one screen,  
show locations of each on sketch.