

MISSISSIPPI DEPARTMENT OF NATURAL RESOURCES

Bureau of Land and Water Resources

Southport Mall

P.O. Box 10631

Jackson, Mississippi 39209

WATER WELL DRILLERS LOG

Jale
F 204e

HICKS WELL CO.
P.O. Box 157
Senatobia, MS 38668

Tate

5/15 1984
date well completed

county well located

LANDOWNER: <u>Bubba King</u>	description of formations encountered		from	to
<u>Senatobia, Ms.</u> (mailing address) <u>38668</u>	<u>Red clay</u>		<u>0</u>	<u>20</u>
WELL LOCATION: sec. <u>36</u> T. <u>5</u> N. R. <u>8</u> E. <u>1</u> miles <u>W</u> of <u>Senatobia</u> (distance) (direction) (nearest town)	<u>Red Sand</u>		<u>20</u>	<u>50</u>
WELL PURPOSE: <u>Home</u> (home, irrigation, municipal, industrial)	<u>Dravel</u>		<u>50</u>	<u>125</u>
WELL COMPLETION DATA: (1) diameter (inches) <u>4</u>	<u>White Clay & Sand</u>		<u>125</u>	<u>170</u>
(2) total depth (feet) <u>190</u>	<u>White Sand</u>		<u>170</u>	<u>190</u>
(3) static water level (feet) <u>160</u> ^{below} above top of ground.				
(4) casing <u>PVC</u> , <u>160</u> (material) (depth) <u>4"</u> (size) if telescope see back.				
(5) screen <u>10</u> , <u>150</u> (length) (depth to top) <u>010</u> , <u>PVC</u> (size) (material)				
(6) pump <u>3/4</u> , <u>10</u> (HP) (yield gpm) <u>220V</u> (type power)				
(7) electric log <u>No</u> (yes or no) (organization running log)				
(8) how well bottom plugged <u>Cap</u>				
DRILLERS REMARKS:				


DEPT. OF NATURAL RESOURCES
BUREAU OF LAND & WATER RESOURCES

MAY 23 1984

RECEIVED

If well telescopes please sketch and show depths.

GROUND LEVEL

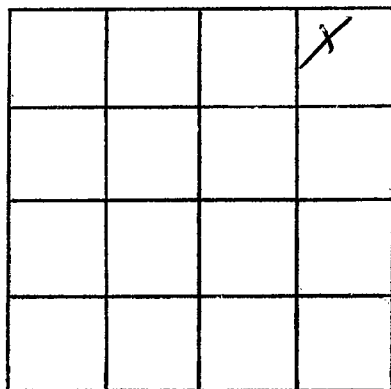

SECTION 36

Please indicate well location X.

ADDITIONAL INFORMATION

If more than one screen,
show locations of each on sketch.