

MISSISSIPPI DEPARTMENT OF NATURAL RESOURCES

Bureau of Land and Water Resources

Southport Mall

P.O. Box 10631

Jackson, Mississippi 39209

WATER WELL DRILLERS LOG

HICKS WELL COMPANY

Tate
F 2048
4-24-85

Tate

4-24-19 85 date well completed

RT. 1, BOX 157

firm name
SENATOBIA, MISS.

county well located

LANDOWNER: Sarah Tyler Buchanan

description of formations encountered

from

to

Rt # 2

Red Clay

0

10

Senatobia MS 38668
(mailing address)

Red Sand

10

30

Gravel & White Sand

30

90

White Sand

90

170

WELL LOCATION:

sec. 36 T 5 N R 8 E
West of Senatobia
(distance) miles (direction) of (nearest town)

WELL PURPOSE: Home
(home, irrigation, municipal, industrial)

WELL COMPLETION DATA:

- (1) diameter (inches) 4"
- (2) total depth (feet) 170'
- (3) static water level (feet) 100' below top of ground.
- (4) casing PVC, 160' (material), (depth)
4' (size) if telescope see back.
- (5) screen 10' (length), 160' (depth to top)
1/2" (size), PVC (material)
- (6) pump 1/2 (HP), 10 (yield gpm)
220 V (type power)
- (7) electric log NO (yes or no)

(organization running log)

(8) how well bottom plugged Cap


RECEIVED
JUL 1 - 1985

DRILLERS REMARKS:

Department of Natural Resources
Bureau of Land & Water Resources

If well telescopes please sketch and show depths.

GROUND LEVEL

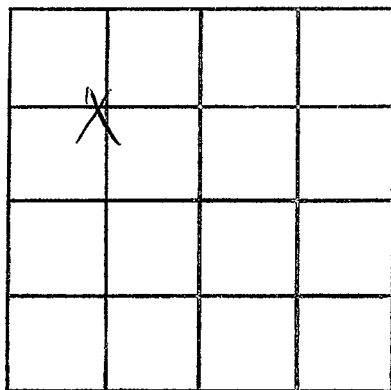

SECTION 36

Please indicate well location X.

ADDITIONAL INFORMATION

If more than one screen,
show locations of each on sketch.