

MISSISSIPPI DEPARTMENT OF NATURAL RESOURCES

Bureau of Land and Water Resources

Southport Mall

P.O. Box 10631

Jackson, Mississippi 39209

WATER WELL DRILLERS LOG

Tate
F 2009
5/16/85

5/16/85
date well completed

Sellitt
firm name

Tate
county well located

LANDOWNER: Marvin Flom
Rt. 2 Box 164A
Colliwater
(mailing address)

WELL LOCATION:
sec 11 T 5 S R 78 E
5 miles W of Colliwater
(distance) (direction) (nearest town)

WELL PURPOSE:
(home, irrigation, municipal, industrial)

WELL COMPLETION DATA:

(1) diameter (inches) 4"

(2) total depth (feet) 175

(3) static water level (feet) 120 below above top of ground.

(4) casing PVC, 135,
(material) (depth)
(size) If telescope see back.

(5) screen 10", 135
(length) (depth to top)
4, PVC
(size) (material)

(6) pump 1/2, 10
(HP) (yield gpm)
elect
(type power)

(7) electric log no
(yes or no)
(organization running log)

(8) how well bottom plugged cap

description of formations encountered	from	to
top soil	0	2
red clay	2	20
hard red gravel	20	40
clay	40	70
hard red clay	70	100
white sand	100	150


RECEIVED
JUN 4 1985

Department of Natural Resources
Bureau of Land & Water Resources

DRILLERS REMARKS:

If well telescopes please sketch and show depths.

GROUND LEVEL

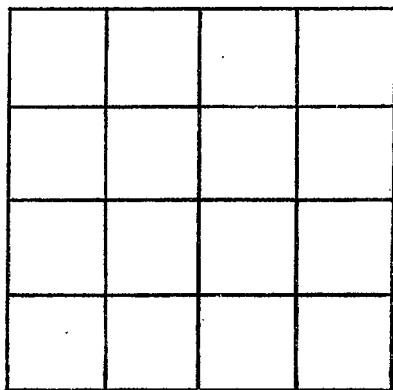

SECTION _____

Please indicate well location X.

ADDITIONAL INFORMATION

If more than one screen, show locations of each on sketch.