

MISSISSIPPI DEPARTMENT OF NATURAL RESOURCES

Bureau of Land and Water Resources

Southport Mall

P.O. Box 10631

Jackson, Mississippi 39209

WATER WELL DRILLERS LOG

HICKS WELL COMPANY

RT. 1 BOX 157
firm name

SENATORIA, MISS.

TATA

county well located

Tate
F 2050
5-10-85

5-10-19 85
date well completed

LANDOWNER: Cland Bachanner

Rt # 3 gravel Ridge

Senatoria MS 38068
(mailing address)

description of formations encountered

from to

Red clay 0 10

Red Sand 10 30

Gravel & white Sand 30 50

White Sand 50 125

WELL LOCATION:

sec. 24 T. 5 N. R. 8 E.
1-2 (S) (W)
4 miles NW of Senatoria
(distance) (direction) (nearest town)

WELL PURPOSE: Home
(home, irrigation, municipal, industrial)

WELL COMPLETION DATA:

(1) diameter (inches) 4"
(2) total depth (feet) 125'
(3) static water level (feet) 60' below above top of ground.

(4) casing PVC, 115'
(material) (depth)
4"
(size) if telescope see back.

(5) screen 10', 115'
(length) (depth to top)
1/2", PVC
(size) (material)

(6) pump 1/2, 10
(HP) (yield gpm)
220 V
(type power)

(7) electric log NO
(yes or no)
(organization running log)

(8) how well bottom plugged Cap


DRILLERS REMARKS:

RECEIVED
JUL 1 - 1985

Department of Natural Resources
Bureau of Land & Water Resources

If well telescopes please sketch and show depths.

GROUND LEVEL

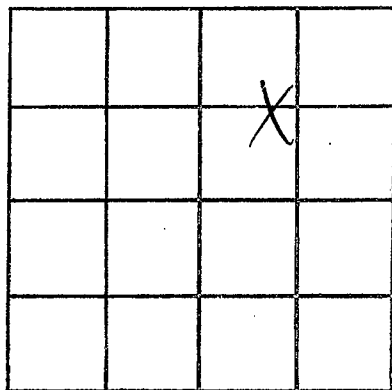

SECTION 24

Please indicate well location X.

ADDITIONAL INFORMATION

If more than one screen, show locations of each on sketch.