

MISSISSIPPI DEPARTMENT OF NATURAL RESOURCES

Bureau of Land and Water Resources

Southport Mall

P.O. Box 10631

Jackson, Mississippi 39209

WATER WELL DRILLERS LOG

TATE
F2052

HICKS WELL COMPANY

1-22 1986
date well completed

RI. 1 BOX 157
firm name
SENATORIA, MISS.

Jata
county well located

LANDOWNER: James Mcghee

description of formations encountered

from

to

Rt #2 Box 17

Senatoria MS 38668
(mailing address)

Red clay

0

10

Red sand & gravel

10

30

Gravel

30

95

White sand

95

140

WELL LOCATION:

sec. 14 T 5 N R P E
S W

3 miles NW of Senatoria
(distance) (direction) (nearest town)

WELL PURPOSE: Drain
(home, irrigation, municipal, industrial)

WELL COMPLETION DATA:

- (1) diameter (inches) 4"
- (2) total depth (feet) 140'
- (3) static water level (feet) 80' below above top of ground.
- (4) casing Pvc, 130',
(material) (depth)
4" if telescope see back.
(size)
- (5) screen 10", 130'
(length) (depth to top)
013, Pvc
(size) (material)
- (6) pump 1/2, 10
(HP) (yield gpm)
280 W
(type power)
- (7) electric log NO
(yes or no)

(organization running log)

(8) how well bottom plugged Cef


DRILLERS REMARKS:

RECEIVED
MAY 19 1986

Department of Natural Resources
Bureau of Land & Water

If well telescopes please
sketch and show depths.

GROUND LEVEL

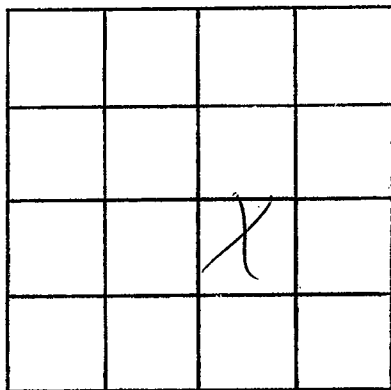

SECTION 14

Please indicate well location X.

ADDITIONAL INFORMATION

If more than one screen,
show locations of each on sketch.