

MISSISSIPPI DEPARTMENT OF NATURAL RESOURCES
 Bureau of Land and Water Resources
 Southport Mall
 P.O. Box 10631
 Jackson, Mississippi 39209
WATER WELL DRILLERS LOG

TATE
F 2054

3-1-1986 HICKS WELL COMPANY J. to
 date well completed firm name county well located
 RT. 1 - BOX 157

LANDOWNER:	description of formations encountered	from	to
Mrs. C. Cook Box #1 Coldwater, MS 38618 (mailing address)	Red clay	0	20
	Red sand + gravel	20	60
	Black clay	60	286
	White sand	286	320


WELL LOCATION:
 sec. 5 T 5 N R 8 E
 S W
 1 miles E of Arkabutla
 (distance) (direction) (nearest town)

WELL PURPOSE: None
 (home, irrigation, municipal, industrial)

WELL COMPLETION DATA:

(1) diameter (inches) 4"
 (2) total depth (feet) 320'
 (3) static water level (feet) 180 below above top of ground.
 (4) casing PVC, 305'
 (material) (depth)
4" if telescope see back.
 (size)
 (5) screen 15', 305'
 (length) (depth to top)
013, PVC
 (size) (material)
 (6) pump 3/4 10
 (HP) (yield gpm)
220 V
 (type power)
 (7) electric log no
 (yes or no)
 (organization running log)
 (8) how well bottom plugged Cap


DRILLERS REMARKS:

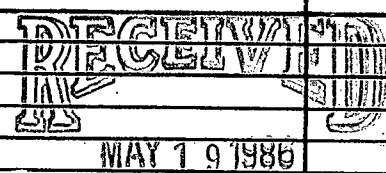

Department of Natural Resources
 Bureau of Land & Water Resources
 Jackson, Mississippi 39209

If well telescopes please sketch and show depths.

GROUND LEVEL

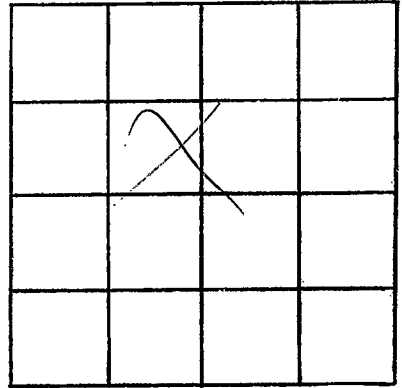

SECTION 5

Please indicate well location X.

ADDITIONAL INFORMATION

If more than one screen,
show locations of each on sketch.