




If well telescopes please  
sketch and show depths.

GROUND LEVEL

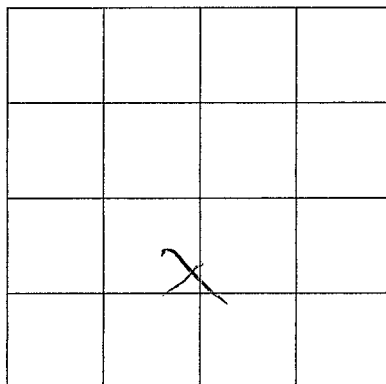

SECTION

5

Please indicate well location X.

ADDITIONAL INFORMATION

If more than one screen,  
show location of each on sketch.