

MISSISSIPPI DEPARTMENT OF NATURAL RESOURCES

Bureau of Land and Water Resources

P.O. Box 10631

Jackson, Mississippi 39209

WATER WELL DRILLERS LOG

COUNTY WELL LOCATED TATE	
WELL NUMBER F	CODED
2064	
DATE WELL COMPLETED 6-1-89	

PERMIT NUMBER
NAME OF DRILLING FIRM HICKS WELL CO

NAME & MAILING ADDRESS OF LANDOWNER Britt Boyd NT Coldwater MS-38618			
WELL LOCATION: SEC	TOWNSHIP	RANGE	
35	5	N	8 <small>W</small>
DISTANCE	DIRECTION	NEAREST TOWN	
2 Miles	WEST	Coldwater	
OTHER LANDMARK			
WELL PURPOSE: <input checked="" type="checkbox"/> Home, Irrigation, Municipal, Industrial, Fish Pond, etc.			

PUMP DATA			
PUMP TYPE (Circle One): <input checked="" type="checkbox"/> Submersible, Turbine, Jet, Flowing Well, Other (Describe) _____			
POWER TYPE (Circle One): <input checked="" type="checkbox"/> Electric, Tractor, Diesel, Gasoline, Butane, Other (Describe) _____ H/P 34			
Pump Capacity (GPM)	No. of Stages	Setting Depth	
10	9	80 FT.	
PUMP TEST			
Well yielded _____ GPM with			
a drawdown of _____ ft.			
after _____ hours of pumping			

WELL DATA			
Well Depth 130	Casing Diameter (In.) 4"	Casing Length (Ft.) 120	
Type of Casing PVC	Hole Depth 130	Depth to Static Water Level 60	
TYPE OF COMPLETION: (Circle One or More): <input checked="" type="checkbox"/> Gravel Packed, Underreamed, Telescoped, Natural Development, Open Hole, Other (Describe) _____			
Top of Lap Pipe or Reduction in Casing FEET IF TELESCOPED OR MORE THAN ONE SCREEN: USE BACK PAGE			

LOG DATA	
TYPE OF LOG RUN (Circle One): <input type="checkbox"/> No Log Run, Electric, Gamma Ray, Density, Sonic, Neutron, Other (Describe) _____	
Name of Organization Running Log	

SCREEN DATA		
Diameter - Inches 4"	Length - Feet 10	Slot Size - Inches 013
Screen Type PVC		Depth to Bottom - Feet 130


GEOLOGIC DATA (Office Use Only)			
Surface Elev.	Geologic Unit	Unit Thickness	Depth to Top
Subs. SWL	Date	Analysis	Aquifer Test
Driller's Remarks			

DESCRIPTION OF FORMATIONS ENCOUNTERED	FROM TO		FORMATIONS (Continued)	FROM TO	
	CLAY	0		20	<div style="font-size: 2em; font-weight: bold; border: 1px solid black; padding: 5px; margin-bottom: 10px;">RECEIVED</div> <div style="font-size: 1.5em; font-weight: bold; margin-bottom: 10px;">JUN 8 1989</div> <div style="font-weight: bold;">Department of Natural Resources Bureau of Land & Water Resources</div>
W-CLAY & SAND	20	80			
W-SAND	80	130			

IF MORE SPACE IS NEEDED, USE BACK

If well telescopes please
sketch and show depths.

GROUND LEVEL

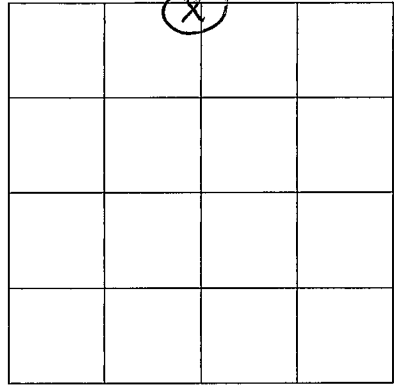

SECTION _____

Please indicate well location X.

ADDITIONAL INFORMATION

If more than one screen,
show location of each on sketch.