

MISSISSIPPI DEPARTMENT OF NATURAL RESOURCES

Bureau of Land and Water Resources

Southport Mall

P.O. Box 10631

Jackson, Mississippi 39209

WATER WELL DRILLERS LOG

TATE  
F 2067

3-28 1990 LIPE WELL + SUPPLY TATE  
date well completed firm name county well located

LANDOWNER: PERRIN Caldwell, Sr.  
7 MAIN ST.  
SENATOBIA, MS.  
(mailing address)

WELL LOCATION:  
sec. 16 T-5 N R-8 E  
4 miles WEST of SENATOBIA  
(distance) (direction) (nearest town)

WELL PURPOSE: FARM  
(home, irrigation, municipal, industrial)

WELL COMPLETION DATA:

(1) diameter (inches) 4

(2) total depth (feet) 162

(3) static water level (feet) 18 below above of ground.

(4) casing PVC, 152, (material) (depth)  
(size) if telescope see back.

(5) screen 10, 152 (length) (depth to top)  
4, PVC (size) (material)

(6) pump 1/2, 30 (HP) (yield gpm)  
(type power)

(7) electric log NO (yes or no)  
(organization running log)

(8) how well bottom plugged CAP

description of formations encountered	from	to
TOP SOIL - CLAY	0	20
CLAY - GRAVEL - CLAY	20	40
CLAY	40	60
CLAY	60	80
CLAY - SAND	80	100
SAND - CLAY STREAKS	100	120
SAND	120	140
SAND - small clay streaks	140	162


RECEIVED  
MAY 3 1990

Department of Natural Resources  
Bureau of Land & Water Resources

DRILLERS REMARKS:

If well telescopes please  
sketch and show depths.

GROUND LEVEL

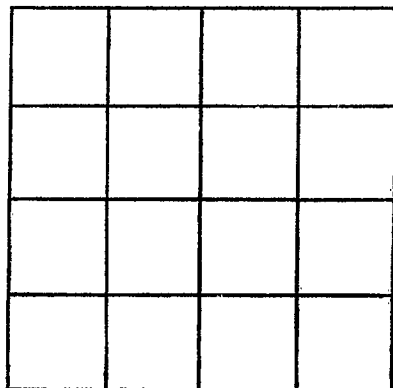

SECTION \_\_\_\_\_

Please indicate well location X.

ADDITIONAL INFORMATION

If more than one screen,  
show locations of each on sketch.