

MISSISSIPPI DEPARTMENT OF NATURAL RESOURCES

Bureau of Land and Water Resources

COUNTY WELL LOCATED TATE	
WELL NUMBER F	CODED
2568	
DATE WELL COMPLETED 5-13-90	

PERMIT NUMBER HICKS WELL CO.
NAME OF DRILLING FIRM RT. 1 BOX 157 SENATOBIA, MS 38668

P.O. Box 10631
Jackson, Mississippi 39209
WATER WELL DRILLERS LOG

NAME & MAILING ADDRESS OF LANDOWNER Jason Wilborn		
P.O. Senatobia		
MS. 38668		
WELL LOCATION: SEC	TOWNSHIP	RANGE
12	5	8
	N S E W	E W
DISTANCE	DIRECTION	NEAREST TOWN
N Miles	NW	Senatobia
OTHER LANDMARK ON STAGE Rd		
WELL PURPOSE (from Irrigation, Municipal, Industrial, Fish Pond, etc.)		

PUMP DATA		
PUMP TYPE (Circle One): <input checked="" type="checkbox"/> Submersible Turbine Jet Flowing Well, Other (Describe) _____		
POWER TYPE (Circle One): <input checked="" type="checkbox"/> Electric Tractor, Diesel, Gasoline, Butane, Other (Describe) _____ H/P _____		
Pump Capacity (GPM)	No. of Stages	Setting Depth
10	9	110 FT.
PUMP TEST		
Well yielded 10 GPM with a drawdown of _____ ft. after _____ hours of pumping		

WELL DATA		
Well Depth 137	Casing Diameter (In.) 4"	Casing Length (Ft.) 127
Type of Casing PVC	Hole Depth 137	Depth to Static Water Level 90
TYPE OF COMPLETION: (Circle One or More): <input checked="" type="checkbox"/> Gravel Packer Underreamed, Telescoped, Natural Development, Open Hole, Other (Describe) _____		
Top of Lap Pipe or Reduction in Casing		
FEET IF TELESCOPED OR MORE THAN ONE SCREEN: USE BACK PAGE		

LOG DATA	
TYPE OF LOG RUN (Circle One): No Log Run, Electric, Gamma Ray, Density, Sonic, Neutron, Other (Describe) _____	
Name of Organization Running Log	

SCREEN DATA		
Diameter - Inches 4'	Length - Feet 10	Slot Size - Inches 013
Screen Type PVC	Depth to Bottom - Feet 10.	


GEOLOGIC DATA (Office Use Only)			
Surface Elev.	Geologic Unit	Unit Thickness	Depth to Top
Subs. SWL	Date	Analysis	Aquifer Test
Driller's Remarks			

DESCRIPTION OF FORMATIONS ENCOUNTERED	FROM	TO	FORMATIONS (Continued)	FROM	TO
RC	0	10	RECEIVED JUN 07 1990 Department of Natural Resources Bureau of Land & Water Resources		
RC & S	10	60			
B.C.	60	90			
W.S.	90	137			

IF MORE SPACE IS NEEDED, USE BACK

If well telescopes please
sketch and show depths.

GROUND LEVEL

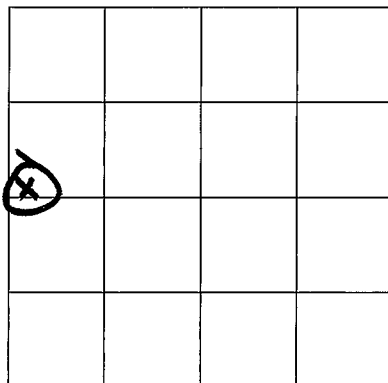

SECTION _____

Please indicate well location X.

ADDITIONAL INFORMATION

If more than one screen,
show location of each on sketch.