

MISSISSIPPI DEPARTMENT OF ENVIRONMENTAL QUALITY

Office of Land and Water Resources

COUNTY WELL LOCATED  
TATE

WELL NUMBER  
F

CODED

2093

DATE WELL COMPLETED  
6-20-95

PERMIT NUMBER  
**HICKS WELL CO.**

NAME OF DRILLING FIRM  
RT. 1 BOX 157  
SENATOBIA, MS 38668

P. O. Box 10631  
Jackson, MS 39289-0631  
WATER WELL DRILLERS LOG

NAME & MAILING ADDRESS OF LANDOWNER  
Gloria Marrow

RT. 2 Box 14 E Senatobia

WELL LOCATION: SEC 13 TOWNSHIP 5 N RANGE 8 E

DISTANCE 2 Miles N/E of Senatobia

OTHER LANDMARK  
By phone tower

WELL PURPOSE (Circle one) Home Irrigation, Municipal, Industrial, Fish Pond, etc.

PUMP DATA

PUMP TYPE (Circle One):  
Submersible Turbine, Jet, Flowing Well,  
Other (Describe) \_\_\_\_\_

POWER TYPE (Circle One):  
Electric Tractor, Diesel, Gasoline, Butane,  
Other (Describe) \_\_\_\_\_ H/P 1/2

Pump Capacity (GPM) 10 No. of Stages 9 Setting Depth 100' FT.

PUMP TEST

Well yielded \_\_\_\_\_ GPM with  
a drawdown of \_\_\_\_\_ ft.  
after \_\_\_\_\_ hours of pumping

WELL DATA

Well Depth 130' Casing Diameter (In.) 4" Casing Length (Ft.) 120'

Type of Casing PVC Hole Depth 130' Depth to Static Water Level 80'

LOG DATA

TYPE OF LOG RUN (Circle One):  
No Log Run, Electric, Gamma Ray, Density, Sonic, Neutron,  
Other (Describe) \_\_\_\_\_

Name of Organization Running Log \_\_\_\_\_

TYPE OF COMPLETION: (Circle One or More):  
Gravel Packed, Underreamed, Telescoped,  
Natural Development, Open Hole, Other  
(Describe) \_\_\_\_\_

WELL GROUTED TO A DEPTH OF 10 FEET  
Type Grout (circle one): Cement, Bentonite, or Mix

GEOLOGIC DATA (Office Use Only)

Surface Elev.	Geologic Unit	Unit Thickness	Depth to Top
Subs. SWL	Date	Analysis	Aquifer Test

SCREEN DATA

Diameter - Inches 4" Length - Feet 10' Slot Size - Inches 0.13

Screen Type PVC Depth to Bottom - Feet 10'

Driller's Remarks

Top of Lap Pipe or Reduction in Casing

FEET IF TELESOPED OR MORE THAN ONE SCREEN: USE BACK PAGE

DESCRIPTION OF FORMATIONS ENCOUNTERED	FROM	TO
<u>Red Sand</u>	<u>0</u>	<u>60</u>
<u>Sand &amp; Clay</u>	<u>60</u>	<u>80</u>
<u>White Sand</u>	<u>80</u>	<u>130</u>

FORMATIONS (Continued)

FROM	TO

**RECEIVED**


**JUL 24 1995**

Dept. of Environmental Quality  
Office of Land & Water Resources

IF MORE SPACE IS NEEDED, USE BACK

If well telescopes please sketch and show depths.

GROUND LEVEL

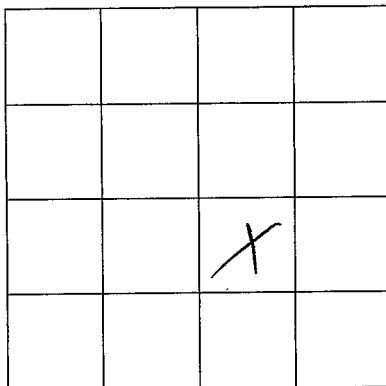

SECTION 13

Please indicate well location X.

ADDITIONAL INFORMATION

If more than one screen,  
show location of each on sketch.