

Date  
 F 2094  
 12/17/76

MISSISSIPPI  
 BOARD OF WATER COMMISSIONERS  
 416 North State Street  
 Jackson, Mississippi 39201

WATER WELL DRILLERS LOG

12-17-1976 date well completed  
 Dick's Well Co. firm name  
 Tate county well located


LANDOWNER: Carl Crawford Rt. 4	description of formations encountered	from	to
Coldwater, Ms. (mailing address)			
WELL LOCATION: sec. 6 T. 5 N. R. 8 E. 6 miles W of Coldwater (distance) (direction) (nearest town)	Red Clay	0	20
	Red Sand	20	40
	Gravel	40	95
	Clay & Sand	95	120
	White Sand	120	147
WELL PURPOSE: <del>drinking</del> (home, irrigation, municipal, industrial)			
WELL COMPLETION DATA: (1) diameter (inches) 4 1/2"			
(2) total depth (feet) 147			
(3) static water level (feet) 100 below top of ground			
(4) casing PVC 4 1/2" (material) 147 (depth)			
(5) screen 4' (length) (depth to top)			
(6) pump 420 (HP) 10 (yield gpm)			
(7) electric log No (yes or no)			
(8) how well bottom plugged Cas			
DRILLERS REMARKS:			

RECEIVED

JAN 4 1977

If well telescopes please sketch and show depths.

GROUND LEVEL

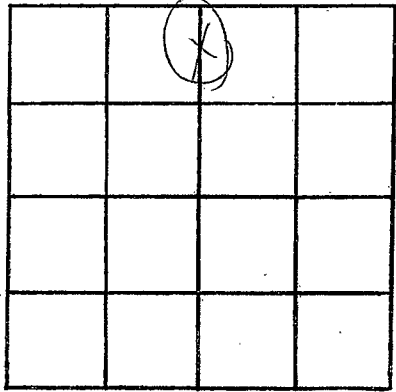

SECTION 6

Please indicate well location X.

ADDITIONAL INFORMATION

If more than one screen,  
show locations of each on sketch.