

MISSISSIPPI DEPARTMENT OF ENVIRONMENTAL QUALITY

Office of Land and Water Resources

P. O. Box 10631

Jackson, MS 39289-0631

WATER WELL DRILLERS LOG

COUNTY WELL LOCATED
TATE

WELL NUMBER CODED
F 2097

DATE WELL COMPLETED
4-10-95

PERMIT NUMBER

NAME OF DRILLING FIRM
HICKS WELL CO.

RT. 1 BOX 157
SENATOBIA, MS 38568

NAME & MAILING ADDRESS OF LANDOWNER
Eddie Waldrop

RT. 2 BOX 14 B

Senatobia, MS

WELL LOCATION: SEC TOWNSHIP RANGE
13 5 N 8 E

DISTANCE DIRECTION NEAREST TOWN
3 Miles **NE** of **Senatobia**

OTHER LANDMARK

WELL PURPOSE: Home, Irrigation, Municipal, Industrial, Fish Pond, etc.
Home

PUMP DATA

PUMP TYPE (Circle One):
 Submersible Turbine, Jet, Flowing Well,
Other (Describe) _____

POWER TYPE (Circle One):
 Electric Tractor, Diesel, Gasoline, Butane,
Other (Describe) _____ H/P **1/8**

Pump Capacity (GPM) 10	No. of Stages 9	Setting Depth 120 FT.
----------------------------------	---------------------------	---------------------------------

PUMP TEST

Well yielded _____ GPM with
a drawdown of _____ ft.
after _____ hours of pumping

WELL DATA

Well Depth 155'	Casing Diameter (In.) 4"	Casing Length (Ft.) 145'
Type of Casing PVC	Hole Depth 155'	Depth to Static Water Level 100'

TYPE OF COMPLETION: (Circle One or More):
 Gravel Packed Underreamed, Telescoped,
Natural Development, Open Hole, Other
(Describe) _____

LOG DATA

TYPE OF LOG RUN (Circle One): No Log Run,
Electric, Gamma Ray, Density, Sonic, Neutron,
Other (Describe) _____

Name of Organization Running Log

WELL GROUTED TO A DEPTH OF 10' FEET
Type Grout (circle one): Cement, Bentonite, or Mix

GEOLOGIC DATA (Office Use Only)

Surface Elev.	Geologic Unit	Unit Thickness	Depth to Top
Subs. SWL	Date	Analysis	Aquifer Test


Driller's Remarks

Top of Lap Pipe or Reduction in Casing

FEET IF TELESCOPED OR MORE THAN ONE SCREEN: USE BACK PAGE

SCREEN DATA

Diameter - Inches 4"	Length - Feet 10'	Slot Size - Inches 013
Screen Type PVC	Depth to Bottom - Feet 10'	

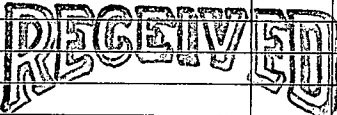
DESCRIPTION OF FORMATIONS ENCOUNTERED	FROM	TO	FORMATIONS (Continued)	FROM	TO
Red Sand	0	60	 JAN 16 1995		
Sand & Clay	60	100			
White Sand	100	155			

Dept. of Environmental Quality
Office of Land & Water Resources

IF MORE SPACE IS NEEDED, USE BACK

If well telescopes please
sketch and show depths.

GROUND LEVEL

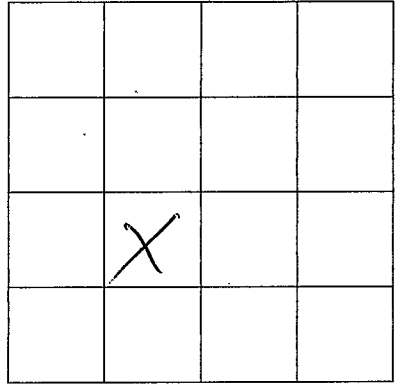

SECTION 13

Please indicate well location X.

ADDITIONAL INFORMATION

If more than one screen,
show location of each on sketch.