

MISSISSIPPI DEPARTMENT OF ENVIRONMENTAL QUALITY

Office of Land and Water Resources

P. O. Box 10631
Jackson, MS 39289-0631
WATER WELL DRILLERS LOG

COUNTY WELL LOCATED TATE	
WELL NUMBER F 2099	CODED
DATE WELL COMPLETED 10-7-96	

PERMIT NUMBER HICK WATER WELL CO.
NAME OF WELL DRILLER 30242 HWY. 4 EAST
SENATOBIA, MS 38668

NAME & MAILING ADDRESS OF LANDOWNER Thomas Wilson			
1068 Wilson Dr.			
Senatobia, MS 38668			
WELL LOCATION:	SEC	TOWNSHIP	RANGE
	25	5	N 8 E
DISTANCE	DIRECTION	NEAREST TOWN	
—	W	Senatobia	
OTHER LANDMARK			
WELL PURPOSE: <input type="checkbox"/> Home, <input type="checkbox"/> Irrigation, <input type="checkbox"/> Municipal, <input type="checkbox"/> Industrial, <input type="checkbox"/> Fish Pond, etc.			

PUMP DATA		
PUMP TYPE (Circle One): <input checked="" type="radio"/> Submersible <input type="radio"/> Turbine <input type="radio"/> Jet <input type="radio"/> Flowing Well, Other (Describe) _____		
POWER TYPE (Circle One): <input checked="" type="radio"/> Electric <input type="radio"/> Tractor, <input type="radio"/> Diesel, <input type="radio"/> Gasoline, <input type="radio"/> Butane, Other (Describe) _____ H/P 1/2		
Pump Capacity (GPM) 10	No. of Stages	Setting Depth 100 FT.
PUMP TEST		
Well yielded no GPM with a drawdown of Test ft. after _____ hours of pumping		

WELL DATA		
Well Depth 152	Casing Diameter (In.) 4	Casing Length (Ft.) 142
Type of Casing PVC	Hole Depth 152	Depth to Static Water Level 60
TYPE OF COMPLETION: (Circle One or More): <input checked="" type="radio"/> Gravel Packed, <input type="radio"/> Underreamed, <input type="radio"/> Telescoped, <input type="radio"/> Natural Development, <input type="radio"/> Open Hole, <input type="radio"/> Other (Describe) _____		
WELL GROUTED TO A DEPTH OF 3 FEET Type Grout (circle one): <input checked="" type="radio"/> Cement, <input type="radio"/> Bentonite, or Mix		

LOG DATA	
TYPE OF LOG RUN (Circle One): <input checked="" type="radio"/> No Log Run <input type="radio"/> Electric, <input type="radio"/> Gamma Ray, <input type="radio"/> Density, <input type="radio"/> Sonic, <input type="radio"/> Neutron, Other (Describe) _____	
Name of Organization Running Log	

SCREEN DATA		
Diameter - Inches 4	Length - Feet 10	Slot Size - Inches .013
Screen Type PVC Slot	Depth to Bottom - Feet 142	

GEOLOGIC DATA (Office Use Only)			
Surface Elev.	Geologic Unit	Unit Thickness	Depth to Top
Subs. SWL	Date	Analysis	Aquifer Test


Driller's Remarks	
Top of Lap Pipe or Reduction in Casing	

DESCRIPTION OF FORMATIONS ENCOUNTERED	FROM	TO
Red Clay	0	10
Red Sand	10	40
Gravel	40	60
White Clay + Sand	60	90
White Sand	90	152

FEET	IF TELESCOPED OR MORE THAN ONE SCREEN, USE BACK PAGE
FORMATION	FROM TO
RECEIVED	
APR 11 1997	
Dept. of Environmental Quality Office of Land & Water Resources	
IF MORE SPACE IS NEEDED, USE BACK	

If well telescopes please
sketch and show depths.

GROUND LEVEL

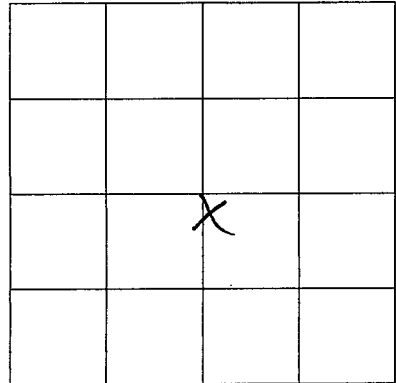

SECTION 25

Please indicate well location X.

ADDITIONAL INFORMATION

If more than one screen,
show location of each on sketch.