

CODED

MISSISSIPPI
BOARD OF WATER COMMISSIONERS
416 North State Street
Jackson, Mississippi 39201

CODED

WATER WELL DRILLERS LOG

Date
G 1
3-6-68

3-6 1968 date well completed Harris Bros firm name Tate county well located

LANDOWNER: Raymond Crawford Rte. 2 Coldwater
(mailing address)

description of formations encountered	from to	
top soil	0	15
red clay	15	30
clay + fine sand	30	100
coarse sand	100	120

WELL LOCATION:
sec. 12 T. 5 N. R. 7 E
2 1/2 miles S W Suite. Poayville
(distance) (direction) (nearest town)

WELL PURPOSE: none
(home, irrigation, municipal, industrial)

WELL COMPLETION DATA:

(1) diameter (inches) 4"

(2) total depth (feet) ~~100~~ 120

(3) static water level (feet) 80 below above top of ground.

(4) casing P. luster 113'
(material) (depth)
4" if telescope see back.
(size)

(5) screen 7' 113'
(length) (depth to top):
008 P. luster
(size) (material)

(6) pump 3/4 10
(HP) (yield gpm)
elec.
(type power)

(7) electric log no
(yes or no)

(organization running log)

(8) how well bottom plugged back
shot

CODED


DEC 23 1968

MISS. Bd. OF WATER COM.

DRILLERS REMARKS:

If well telescopes please sketch and show depths.

GROUND LEVEL

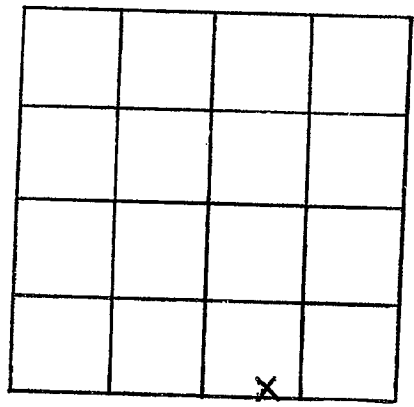

SECTION 12

Please indicate well location X.

ADDITIONAL INFORMATION

If more than one screen, show locations of each on sketch.