

Date  
 G 2  
 11-68

MISSISSIPPI  
 BOARD OF WATER COMMISSIONERS  
 416 North State Street  
 Jackson, Mississippi 39201

CODED

CODED

WATER WELL DRILLERS LOG

1968 Shelby Neyman  
 firm name

Date

date well completed

county well located

LANDOWNER: Mr. & Mrs. Williams  
 R. F. D. - 2  
 Senatobia Miss  
 (mailing address)

description of formations encountered

from to

WELL LOCATION:  
 sec. 14 T 5 N R 7 E  
 6 miles East of Coldwater Miss  
 (distance) (direction) (nearest town)

Red clay 0 20  
 Red Sandy Gravel 20 100  
 white sand 100 112

WELL PURPOSE: Home  
 (home, irrigation, municipal, industrial)

WELL COMPLETION DATA:

- (1) diameter (inches) 2
- (2) total depth (feet) 112
- (3) static water level (feet) 70 below above top of ground.
- (4) casing Galv. 105 (material) (depth)
- (size) If telescope see back.
- (5) screen 5ft (length) (depth to top)
- 1/2 Johnson st st (size) (material)
- (6) pump 3/4 4 (HP) (yield gpm)
- Electric (type power)
- (7) electric log No (yes or no)
- No (organization running log)
- (8) how well bottom plugged Rubber Seal

CODED


NOV 12 1968

MISS. BD. OF  
 WATER COMM.

DRILLERS REMARKS:

If well telescopes please sketch and show depths.

GROUND LEVEL

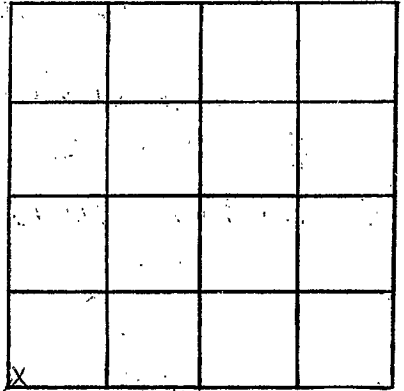

*well X*

SECTION 14

Please indicate well location X.

ADDITIONAL INFORMATION

If more than one screen, show locations of each on sketch.