

Late
 43
 11-30-68

MISSISSIPPI
 BOARD OF WATER COMMISSIONERS
 416 North State Street
 Jackson, Mississippi 39201
 WATER WELL DRILLERS LOG

CODED

CODED

NOV 30 1968
 date well completed

TIM PENIX
 firm name

TATE
 county well located

LANDOWNER	Description of formations encountered	from	to
ROOSEVELT LEVERSA RED 2	CLAY DIAT	0	30
COLDWATER MISS. (mailing address)	GRAVEL & SAND SAND	30	120 130
WELL LOCATION:			
sec. <u>16</u> T. <u>5</u> N R. <u>7</u> E S W			
<u>3 1/2</u> miles <u>SOUTH EAST</u> of <u>COLDWATER</u> (distance) (direction) (nearest town)			
WELL PURPOSE: <u>HOME</u> (home, irrigation, municipal, industrial)			
WELL COMPLETION DATA:			
(1) diameter (inches) <u>2 IN</u>			
(2) total depth (feet) <u>130 FT.</u>			
(3) static water level (feet) <u>105</u> below top of ground.			
(4) casing <u>PAV.</u> , <u>121</u> , (material) (depth) <u>1 1/2</u> if telescope 'see back. (size) <u>5 FT.</u>			
(5) screen <u>4</u> , <u>126 FT</u> (length) (depth to top) <u>1 1/2</u> , <u>BRASS</u> (size) (material)			
(6) pump _____ (HP) _____ (yield gpm) (type power) _____			
(7) electric log _____ (yes or no) (organization running log) _____			
(8) how well bottom plugged _____			
DRILLERS REMARKS: OWNER INSTALLED 3 HP N PUMP			



CODED

FEB 3 1969

MISS. BD. OF
 WATER COMM.

MISS. BD. OF
 WATER COMM.

If well telescopes please sketch and show depths.

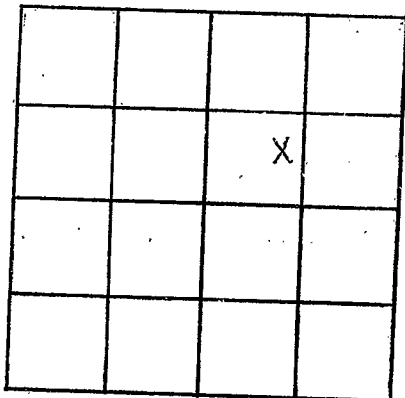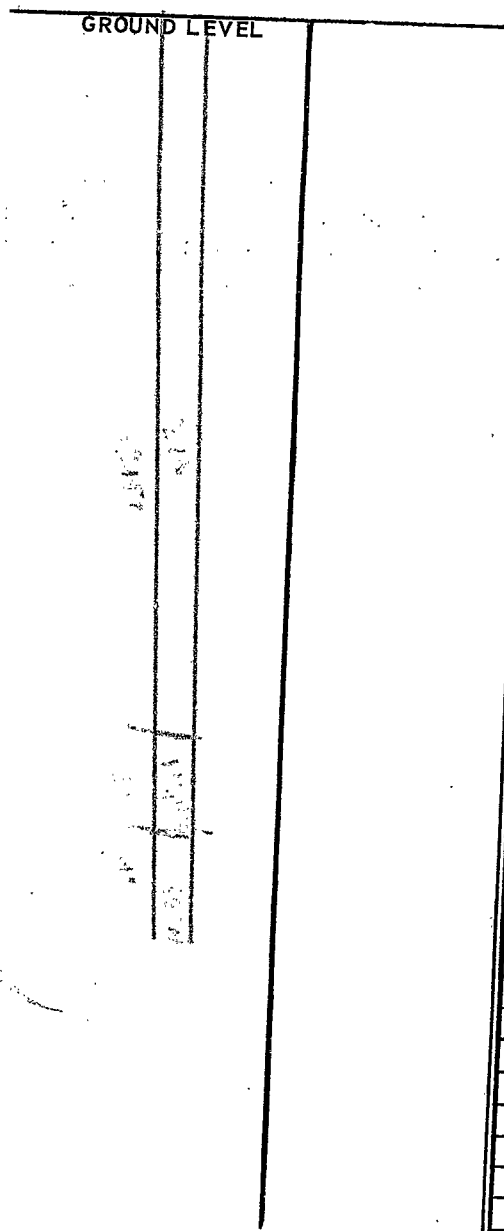

SECTION 16

Please indicate well location X.

ADDITIONAL INFORMATION

If more than one screen,
show locations of each on sketch.