

CODED

MISSISSIPPI
BOARD OF WATER COMMISSIONERS
416 North State Street
Jackson, Mississippi 39201

WATER WELL DRILLERS LOG

CODED

Tate
G4
4-10-68

4-10 1968 Harris Bros Tate
date well completed firm name county well located

LANDOWNER: J.E. Ashmore
Rte 2
Coldwater
(mailing address)

description of formations encountered

from to

top soil	0	20
R. sand + B. Clay	20	45
Red gravel	45	60
B. Clay	60	110
Clay + sand	110	140
W. sand	140	160

WELL LOCATION:
sec. 2 T 5 N R 7 E
7 1/2 miles S E of Senatobia
(distance) (direction) (nearest town)

WELL PURPOSE: none
(home, irrigation, municipal, industrial)

WELL COMPLETION DATA:

- (1) diameter (inches) 4"
- (2) total depth (feet) 160
- (3) static water level (feet) 100 ^{below}/_{above} top of ground.
- (4) casing Plaster 146 (material) (depth)
4" (size) if telescope see back.
- (5) screen 14 (length) 146 (depth to top)
008 (size) Plaster (material)
- (6) pump 3/4 (HP) 10 (yield gpm)
elec. (type power)
- (7) electric log no (yes or no)
(organization running log)
- (8) how well bottom plugged back

CODED


MAR 7 1969

DRILLERS REMARKS:

MISS. BD. OF
WATER COMM.

If well telescopes please sketch and show depths.

GROUND LEVEL

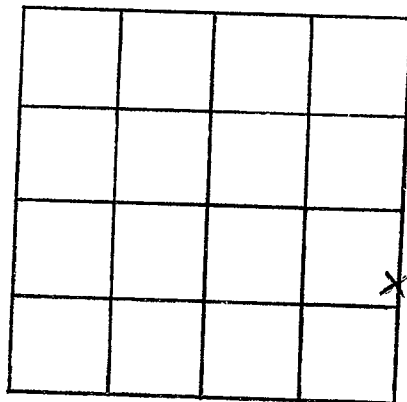

SECTION 2

Please indicate well location X.

ADDITIONAL INFORMATION

If more than one screen,
show locations of each on sketch.