

Zate
G5
1-10-69

MISSISSIPPI
 BOARD OF WATER COMMISSIONERS
 416 North State Street
 Jackson, Mississippi 39201

CODED

CODED

WATER WELL DRILLERS LOG

T-10 1969 Harris Bros Zate
 date well completed firm name county well located

LANDOWNER: W. J. Holden
pto 1
Senatoria
 (mailing address)

description of formations encountered	from	to
<u>top soil</u>	<u>0</u>	<u>20</u>
<u>gray clay</u>	<u>20</u>	<u>60</u>
<u>fine sand</u>	<u>60</u>	<u>90</u>
<u>Coarse sand</u>	<u>90</u>	<u>100</u>

WELL LOCATION:
 sec 22 T 5 N R 7 E
5 miles NE of Senatoria
 (distance) (direction) (nearest town)

WELL PURPOSE: none
 (home, irrigation, municipal, industrial)

WELL COMPLETION DATA:
 (1) diameter (inches) 4"
 (2) total depth (feet) 100'
 (3) static water level (feet) 100 ^(below) _(above) top of ground.
 (4) casing Plastic, 93'
 (material) (depth)
4" if telescope see back.
 (size)
 (5) screen 7', 93'
 (length) (depth to top)
008 Plastic
 (size) (material)
 (6) pump 3/4 10
 (HP) (yield gpm)
elec.
 (type power)
 (7) electric log no
 (yes or no)
 (organization running log)
 (8) how well bottom plugged wash
shot

CODED


MAR 13 1969

DRILLERS REMARKS:

MISS. Bd. OF
 WATER COMM.

If well telescopes please sketch and show depths.

GROUND LEVEL

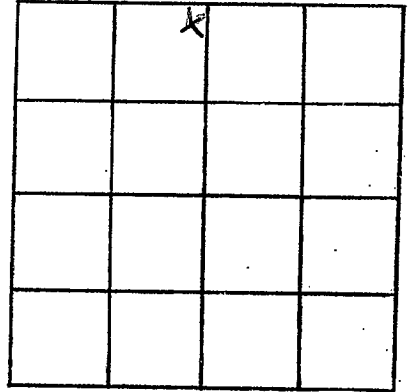

SECTION 22

Please indicate well location X.

ADDITIONAL INFORMATION

If more than one screen,
show locations of each on sketch.