

CODED

MISSISSIPPI
BOARD OF WATER COMMISSIONERS
416 North State Street
Jackson, Mississippi 39201

WATER WELL DRILLERS LOG

Tate
G9
8-11-69

8-11-1969 Bob Smith Tate
date well completed firm name county well located

LANDOWNER:
Weidlen
Ludger, Miss.
(mailing address)

description of formations encountered	from	to
top soil	0	5
red clay	5	20
gravel & sand	20	85
sand	85	160

WELL LOCATION:
sec. 12 T. 5 N. R. 7 E.
D miles East of Columbus
(distance) (direction) (nearest town)

WELL PURPOSE: None
(home, irrigation, municipal, industrial)

- WELL COMPLETION DATA:
- (1) diameter (inches) 4
 - (2) total depth (feet) 160
 - (3) static water level (feet) 120 below top of ground.
 - (4) casing 4" Plastic 160 (material) (depth)
 - (size) if telescope see back.
 - (5) screen 20 140 (length) (depth to top)
 - 4" Plastic (size) (material)
 - (6) pump 3/4 15 (HP) (yield gpm)
 - 8 hp (type power)
 - (7) electric log no (yes or no)
 - (organization running log)
 - (8) how well bottom plugged plugged


DRILLERS REMARKS:

good drilling

REC'D 12 1969
MISSISSIPPI BOARD OF WATER COMMISSIONERS

If well telescopes please sketch and show depths.

GROUND LEVEL

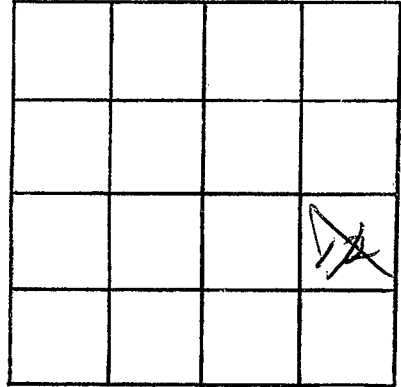

SECTION 12

Please indicate well location X.

ADDITIONAL INFORMATION

A series of horizontal lines for writing additional information.

If more than one screen, show locations of each on sketch.