

TATE

G 15

11-19-69

MISSISSIPPI
 BOARD OF WATER COMMISSIONERS
 416 North State Street
 Jackson, Mississippi 39201

CODED

WATER WELL DRILLERS LOG

11-19

1969 Harris Bros.

Tate

date well completed

firm name

county well located

LANDOWNER: Charles S. Haven

pto. 3

Coldwater

(mailing address)

description of formations encountered

from

to

top soil

0 15

sand + clay

15 95

Coarse sand

95 107

WELL LOCATION:

sec. 13 T 5 N R 7 E
 7 miles SW of Ponquille
 (distance) (direction) (nearest town)

WELL PURPOSE: none
 (home, irrigation, municipal, industrial)

WELL COMPLETION DATA:

- (1) diameter (inches) 4
- (2) total depth (feet) 107
- (3) static water level (feet) 60 ^{below} top of ground.
- (4) casing Plastic 100
 (material) (depth)
 4" if telescope see back.
 (size)
- (5) screen 7' 100'
 (length) (depth to top)
008 Plastic
 (size) (material)
- (6) pump 3/4 7
 (HP) (yield gpm)
elec.
 (type power)
- (7) electric log no
 (yes or no)

(organization running log)

(8) how well bottom plugged back


DRILLERS REMARKS:

DEC 29 1969

MISS. Bd. of WATER COMMISSIONERS

If well telescopes please sketch and show depths.

GROUND LEVEL

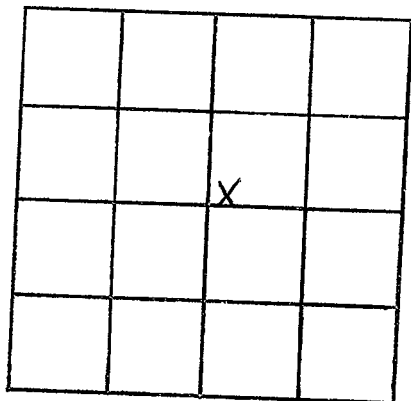

SECTION 13

Please indicate well location X.

ADDITIONAL INFORMATION

If more than one screen, show locations of each on sketch.