

TATE

G16

11-25-69

MISSISSIPPI
 BOARD OF WATER COMMISSIONERS
 416 North State Street
 Jackson, Mississippi 39201

CODED

WATER WELL DRILLERS LOG

11-25

1969

Harris Bros.

Tate

date well completed

firm name

county well located

LANDOWNER: James W. Traynor

description of formations encountered	from	to
	top soil	0
clay & sand	20	90
fine sand	90	135
course sand	135	160

Rte 2

Coldwater

(mailing address)

WELL LOCATION:

sec. 4 T-S N R-7 E
 4 miles E of Coldwater
 (distance) (direction) (nearest town)

WELL PURPOSE: home
 (home, irrigation, municipal, industrial)

WELL COMPLETION DATA:

- (1) diameter (inches) 4"
- (2) total depth (feet) 160
- (3) static water level (feet) 80 ^{below} _{above} top of ground.
- (4) casing Plastic, 146' (material) (depth)
 4" (size) if telescope see back.
- (5) screen 14', 146' (length) (depth to top)
1008, Plastic (size) (material)
- (6) pump 74, 10 (HP) (yield gpm)
elec. (type power)
- (7) electric log no (yes or no)

(organization running log)

(8) how well bottom plugged wash spot


DRILLERS REMARKS:

DEC 29 1969

MISS. BD. OF WATER COMM.

If well telescopes please sketch and show depths.

GROUND LEVEL

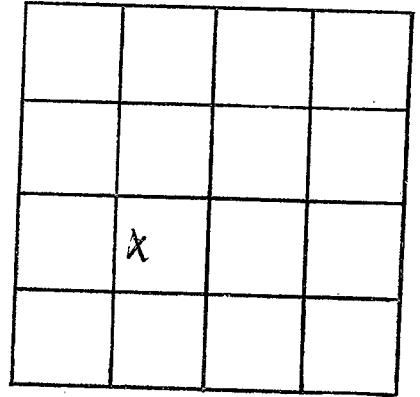

SECTION 4

Please indicate well location X.

ADDITIONAL INFORMATION

If more than one screen,
show locations of each on sketch.