

TATE
G17
12-5-69

MISSISSIPPI
BOARD OF WATER COMMISSIONERS
416 North State Street
Jackson, Mississippi 39201

CODED

WATER WELL DRILLERS LOG

12-5 1969 Harris Bros. Tate
date well completed firm name county well located


LANDOWNER: James Brown Box 141 Coldwater (mailing address)	description of formations encountered	from	to
WELL LOCATION: sec. 5 T 5 N R 7 E 2 miles S of Coldwater (distance) (direction) (nearest town)	top soil	0	20
WELL PURPOSE: home (home, irrigation, municipal, industrial)	white clay	20	65
WELL COMPLETION DATA: (1) diameter (inches) 4 (2) total depth (feet) 130 (3) static water level (feet) 90 below top of ground. (4) casing 4" (size) if telescope see back. Plaster, 123' (material) (depth) (5) screen 7' (length) 123' (depth to top) 008, Plaster (size) (material) (6) pump 3/4 (HP) 10 (yield gpm) elec. (type power) (7) electric log no (yes or no) (organization running log) (8) how well bottom plugged much spit	sand + clay	65	120
	coarse sand	120	130
DRILLERS REMARKS:			

DEC 29 1969

MISS. BD. OF
WATER COMMISSIONERS

If well telescopes please sketch and show depths.

GROUND LEVEL

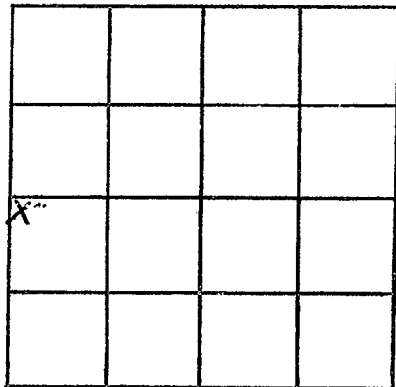

SECTION 5

Please indicate well location X.

ADDITIONAL INFORMATION

If more than one screen,
show locations of each on sketch.