

Tate Co
G 18
4-3-70

MISSISSIPPI
 BOARD OF WATER COMMISSIONERS
 416 North State Street
 Jackson, Mississippi 39201

WATER WELL DRILLERS LOG

4-3-70 date well completed Bob Smith firm name Tate county well located

LANDOWNER: Terry
Independence, Miss.
 (mailing address)

description of formations encountered	depth	
	from	to
<u>top soil</u>	<u>0</u>	<u>5</u>
<u>red clay</u>	<u>5</u>	<u>20</u>
<u>white sand</u>	<u>20</u>	<u>210</u>

WELL LOCATION:
 sec. 10 T. 5 N. R. 7 E. 213
9 miles South of TND
 (distance) (direction) (nearest town)

WELL PURPOSE: Home
 (home, irrigation, municipal, industrial)

WELL COMPLETION DATA:

(1) diameter (inches) 4

(2) total depth (feet) 110

(3) static water level (feet) 80 ^{below} above top of ground.

(4) casing Orbrite, 110
 (material) (depth)
 (size) if telescope see back.

(5) screen 20 90
 (length) (depth to top)
4 Orbrite
 (size) (material)

(6) pump 1/2 10
 (HP) (yield gpm)

Electric
 (type power)

(7) electric log no
 (yes or no)

(organization running log)

(8) how well bottom plugged plugged


DRILLERS REMARKS:
good drilling

MAY 22 1970

MISS. BD. OF
 WATER COMM.

If well telescopes please sketch and show depths.

GROUND LEVEL

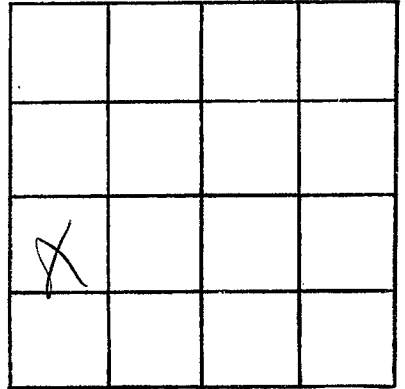

SECTION _____

Please indicate well location X.

ADDITIONAL INFORMATION

If more than one screen,
show locations of each on sketch.