

**MISSISSIPPI  
BOARD OF WATER COMMISSIONERS  
416 North State Street  
Jackson, Mississippi 39201**

**Tate Co**  
**G 19**  
**3-15-70**

**WATER WELL DRILLERS LOG**

3-15 1970      Harris Bros. Tate      \_\_\_\_\_  
 date well completed      firm name      county well located


LANDOWNER: <u>Jeanie Gordon</u> <u>Rt. #2</u>	description of formations encountered	from	to
<u>Senatobia</u> (mailing address)	<u>top soil</u>	<u>0</u>	<u>15</u>
WELL LOCATION: sec. <u>33</u> T <u>5</u> N R. <u>7</u> E <u>100</u>	<u>red sand</u>	<u>15</u>	<u>45</u>
<u>1 1/4</u> miles <u>SE</u> of <u>Senatobia</u> (distance) (direction) (nearest town)	<u>fine sand + clay</u>	<u>45</u>	<u>120</u>
WELL PURPOSE: <u>home</u> (home, irrigation, municipal, industrial)	<u>course sand</u>	<u>120</u>	<u>130</u>
WELL COMPLETION DATA:			
(1) diameter (inches) <u>4</u>			
(2) total depth (feet) <u>130</u>			
(3) static water level (feet) <u>60</u> <u>below</u> above top of ground.			
(4) casing <u>Plastic</u> , <u>123</u> (material) (depth) <u>4</u> if telescope see back. (size)			
(5) screen <u>7'</u> , <u>123'</u> (length) (depth to top)			
<u>008</u> , <u>Plastic</u> (size) (material)			
(6) pump <u>3/4</u> , <u>7</u> (HP) (yield gpm)			
<u>elec.</u> (type power)			
(7) electric log <u>NO</u> (yes or no)			
(organization running log)			
(8) how well bottom plugged <u>brick</u> <u>shot</u>			
DRILLERS REMARKS:			

JULY 17 1970

MISS. Bd. of  
WATER COMMISSIONERS

If well telescopes please sketch and show depths.

GROUND LEVEL

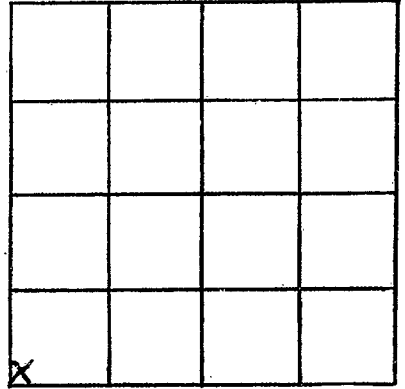

SECTION 3.3

Please indicate well location X.

ADDITIONAL INFORMATION

If more than one screen, show locations of each on sketch.