

Tate Co

G20

4-15-70

3

MISSISSIPPI BOARD OF WATER COMMISSIONERS  
416 North State Street  
Jackson, Mississippi 39201

WATER WELL DRILLERS LOG

4-15 1970  
date well completed

Harris Bros.  
firm name

Tate  
county well located

LANDOWNER: Clyde Scott

pt. 2

Coldwater

(mailing address)

description of formations encountered

from to

top soil

0 20

red sand

20 45

clay + sand

45 120

coarse sand

120 140

WELL LOCATION:

sec 2 T 5 N R 07 100

2 1/2 miles W of Bogalusa  
(distance) (direction) (nearest town)

WELL PURPOSE: None  
(home, irrigation, municipal, industrial)

WELL COMPLETION DATA:

- (1) diameter (inches) 4"
- (2) total depth (feet) 140'
- (3) static water level (feet) 100' <sup>below</sup> above top of ground.
- (4) casing Plastic, 133'  
(material) (depth)
- 4 if telescope see back.  
(size)
- (5) screen 7', 133'  
(length) (depth to top)
- 008, Plastic  
(size) (material)
- (6) pump 3/4 10  
(HP) (yield gpm)
- elec.  
(type power)
- (7) electric log no  
(yes or no)

(organization running log)

(8) how well bottom plugged much  
not


DRILLERS REMARKS:

JUN 17 1970

MISS. DE. OF  
WATER

If well telescopes please sketch and show depths.

GROUND LEVEL

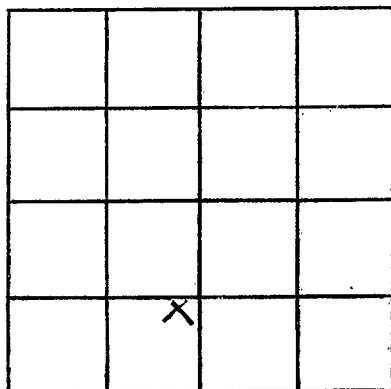

SECTION 2

Please indicate well location X.

ADDITIONAL INFORMATION

If more than one screen,  
show locations of each on sketch.