

TATE  
G-21  
6-8-70

MISSISSIPPI  
BOARD OF WATER COMMISSIONERS  
416 North State Street  
Jackson, Mississippi 39201

CODED

WATER WELL DRILLERS LOG

6-8-1970 Bob Smith Tate  
date well completed firm name county well located

LANDOWNER: Thompson  
Lodgepole, Miss.  
(mailing address)  
WELL LOCATION:  
sec. 1 T. 5 N. R. 7 E. 213  
6 miles (distance) W. of (direction) (nearest town) IND

description of formations encountered	from	to
Top Soil	0	5
red clay	5	30
red sand	30	40
red gravel	40	65
white sand	65	160

WELL PURPOSE: None  
(home, irrigation, municipal, industrial)

WELL COMPLETION DATA:

- (1) diameter (inches) 4
- (2) total depth (feet) 160
- (3) static water level (feet) 93 below top of ground.
- (4) casing Plastic, 160 (material), (depth)  
(size) If telescope see back.
- (5) screen 20, 140 (length), (depth to top)  
4, Plastic (size), (material)
- (6) pump 3/4 (HP), 15 (yield gpm)  
Electric (type power)
- (7) electric log no (yes or no)  
(organization running log)

(8) how well bottom plugged plugged

DRILLERS REMARKS:

good drilling


CODED

AUG 31 1970

MISS. Bd. of  
WATER COMM.

If well telescopes please sketch and show depths.

GROUND LEVEL

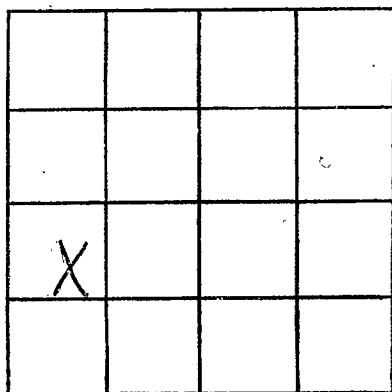

SECTION \_\_\_\_\_

Please indicate well location X.

ADDITIONAL INFORMATION

If more than one screen, show locations of each on sketch.