

MISSISSIPPI  
BOARD OF WATER COMMISSIONERS  
416 North State Street  
Jackson, Mississippi 39201

WATER WELL DRILLERS LOG

**CODED**

TATE  
G23  
9-24-70

9-24-70 19  
date well completed

JIM - REARD  
firm name

TATE  
county well located

LANDOWNER: <u>JESSE JOHNSON JR</u> <u>RT-2</u>	description of formations encountered	from	to
<u>COLDWATER, MISS</u> (mailing address)	<u>DIRT</u> <u>SAND &amp; GRAVEL (120)</u> <u>SAND</u> ✓	<u>0</u> <u>10</u> <u>110</u>	<u>10</u> <u>120</u> <u>130</u>
WELL LOCATION: sec. <u>16</u> T <u>5</u> N R <u>7</u> E S W <u>3</u> miles <u>SE</u> of <u>COLDWATER</u> (distance) (direction) (nearest town)	<u>DIRT</u> <u>SAND &amp; GRAVEL</u> <u>SAND</u>	<u>0</u> <u>10</u> <u>120</u>	<u>10</u> <u>120</u> <u>130</u>
WELL PURPOSE: <u>HOME</u> (home, irrigation, municipal, industrial)			
WELL COMPLETION DATA:			
(1) diameter (inches) <u>2" + 1 1/4"</u>			
(2) total depth (feet) <u>130</u>			
(3) static water level (feet) <u>105</u> below above top of ground.			
(4) casing <u>5/8"</u> (material), <u>126</u> (depth), <u>2" + 1 1/4"</u> (size) if telescope see back.			
(5) screen <u>4'</u> (length), <u>126'</u> (depth to top) <u>1 1/4"</u> (size), <u>BRASS</u> (material)			
(6) pump <u>1/2</u> (HP), <u>3 GPM</u> (yield gpm) <u>ELER</u> (type power)			
(7) electric log <u>NO</u> (yes or no) (organization running log)			
(8) how well bottom plugged <u>OPEN</u>			
DRILLERS REMARKS: <u>OWNER - INSTALLED PUMP</u>	<p align="center"><b>CODED</b></p> <p align="center">OCT 26 1970</p> <p align="right">MISS. BD. OF WATER COMM.</p>		

If well telescopes please sketch and show depths.

GROUND LEVEL

122'

GAUV

2 1/2'


1 1/4"

GAUV

4'

1 1/4"

BRAS

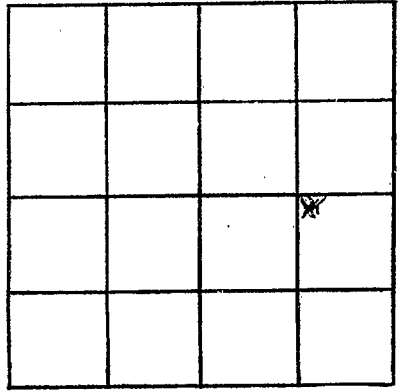

SECTION 16

Please indicate well location X.

ADDITIONAL INFORMATION

If more than one screen, show locations of each on sketch.