

TATE  
G-24  
9-1-70

MISSISSIPPI  
BOARD OF WATER COMMISSIONERS  
416 North State Street  
Jackson, Mississippi 39201

**CODED**

WATER WELL DRILLERS LOG

9-1 1970 Harris Bros. Tate  
date well completed firm name county well located

LANDOWNER: Henry Taylor  
Pt. 2  
Coldwater  
(mailing address)

description of formations encountered	from	to
<u>top soil</u>	<u>0</u>	<u>20</u>
<u>clay and sand</u>	<u>20</u>	<u>130</u>
<u>coarse sand</u>	<u>130</u>	<u>160</u>

WELL LOCATION:  
sec. 1 T 5 N R. 7 E  
1/2 miles W of Poplarville  
(distance) (direction) (nearest town)

WELL PURPOSE: none  
(home, irrigation, municipal, industrial)

- WELL COMPLETION DATA:
- (1) diameter (inches) 4
  - (2) total depth (feet) 160
  - (3) static water level (feet) 100 below top of ground.
  - (4) casing Plastic, 146'  
(material) (depth)  
4 if telescope see back.  
(size)
  - (5) screen 14, 146  
(length) (depth to top)  
008, Plastic  
(size) (material)
  - (6) pump 1, 18  
(HP) (yield gpm)  
clean  
(type power)
  - (7) electric log no  
(yes or no)

**CODED**

(organization running log)  
(8) how well bottom plugged back  
and


DRILLERS REMARKS:

NOV 12 1970

MISS. BD. OF  
WATER COMMISSIONERS

If well telescopes please sketch and show depths.

GROUND LEVEL

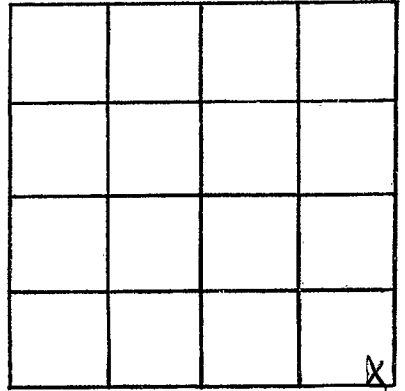

SECTION 1

Please indicate well location X.

ADDITIONAL INFORMATION

If more than one screen, show locations of each on sketch.