

CODED

Tate Co
 G-10-25
 9-69

MISSISSIPPI
 BOARD OF WATER COMMISSIONERS
 416 North State Street
 Jackson, Mississippi 39201

WATER WELL DRILLERS LOG

9-27-1969 Bob Smith Tate
 date well completed firm name county well located


LANDOWNER:	description of formations encountered	from	to
Thomas George Coldwater, Miss. (mailing address)			
	red clay	3	70
	red gravel	30	50
	red T. clay	50	70
	white sand	70	180
WELL LOCATION: sec. 2 T. 5 N. R. 7 E. S miles W of Ind (distance) (direction) (nearest town)			
WELL PURPOSE: (home, irrigation, municipal, industrial)			
WELL COMPLETION DATA: (1) diameter (inches) 4			
(2) total depth (feet) 180			
(3) static water level (feet) 130 below top of ground.			
(4) casing (material) Plastic, (depth) 180			
(size) If telescope see back.			
(5) screen (length) 20, (depth to top) 160			
(size) 4, (material) Plastic			
(6) pump (HP) 3/4, (yield gpm) 15			
(type power) Elec.			
(7) electric log (yes or no) no			
(organization running log)			
(8) how well bottom plugged plugged			
DRILLERS REMARKS: good drilling			

DEC 5 1969

MISSISSIPPI BOARD OF WATER COMMISSIONERS

If well telescopes please sketch and show depths.

GROUND LEVEL

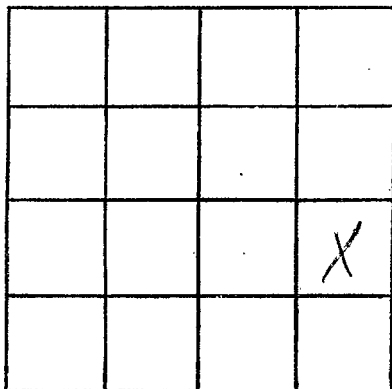

SECTION _____

Please indicate well location X.

ADDITIONAL INFORMATION

If more than one screen,
show locations of each on sketch.