

TATE
G-12-27
4-10-69

MISSISSIPPI
BOARD OF WATER COMMISSIONERS
416 North State Street
Jackson, Mississippi 39201

CODED

WATER WELL DRILLERS LOG

4-10

1969 Harris Bros.

Tate

date well completed

firm name

county well located

LANDOWNER: J. M. Rose

Rt 1

Senatobia

(mailing address)

WELL LOCATION:

sec. 27 T 5 N R. 7 E
4 miles S of Senatobia
(distance) (direction) (nearest town)

WELL PURPOSE: none
(home, irrigation, municipal, industrial)

WELL COMPLETION DATA:

- (1) diameter (inches) 4"
- (2) total depth (feet) 130
- (3) static water level (feet) 80 below above top of ground.
- (4) casing Plastic, 123' (material) (depth)
4" (size) if telescope see back.
- (5) screen 7' (length), 123' (depth to top)
#008 Plastic (size) (material)
- (6) pump 3/4 (HP), 10 (yield gpm)
elec. (type power)
- (7) electric log no (yes or no)

(organization running log)

(8) how well bottom plugged back stop

DRILLERS REMARKS:

description of formations encountered

from

to


| | | |
|-------------|-----|-----|
| top soil | 0 | 20 |
| red sand | 20 | 50 |
| clay + sand | 50 | 75 |
| clay | 75 | 100 |
| fine sand | 100 | 115 |
| coarse sand | 115 | 130 |

DEC 22 1969

MISS. DE. OF
POWER

If well telescopes please sketch and show depths.

GROUND LEVEL

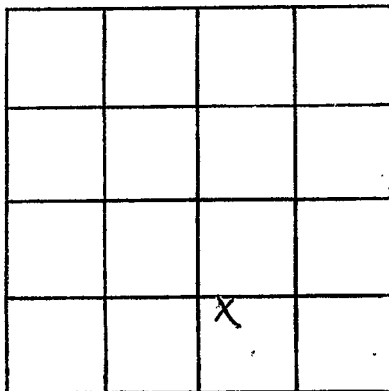

SECTION 27

Please indicate well location X.

ADDITIONAL INFORMATION

If more than one screen, show locations of each on sketch.