

TATE  
G 1328  
8-12-69

MISSISSIPPI  
BOARD OF WATER COMMISSIONERS  
416 North State Street  
Jackson, Mississippi 39201

CODED

WATER WELL DRILLERS LOG

8-12-69 date well completed  
Harris Bros. firm name  
Tate county well located

LANDOWNER: Sidney Wooten  
Rte. 1  
Coldwater  
(mailing address)

description of formations encountered

from to

top soil	0	20
sand + gravel	20	65
clay + sand	65	130
coarse sand	130	150

WELL LOCATION:

sec. 14 T-5 N R-7 E  
8 miles W of Praxin  
(distance) (direction) (nearest town)

WELL PURPOSE: none  
(home, irrigation, municipal, industrial)

WELL COMPLETION DATA:

- (1) diameter (inches) 4"
- (2) total depth (feet) 150
- (3) static water level (feet) 100 below top of ground.
- (4) casing Plastic 143 (material) (depth)  
4" (size) if telescope see back.
- (5) screen 7' 143' (length) (depth to top)  
008 Plastic (size) (material)
- (6) pump 7/4 7 (HP) (yield gpm)  
elec. (type power)
- (7) electric log no (yes or no)

(organization running log)

(8) how well bottom plugged  
shut


DRILLERS REMARKS:

DEC 29 1969

MISS. BD. OF  
WATER COM. S.

If well telescopes please sketch and show depths.

GROUND LEVEL

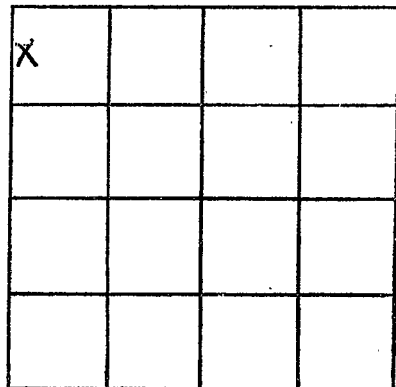

SECTION \_\_\_\_\_

Please indicate well location X.

ADDITIONAL INFORMATION

If more than one screen, show locations of each on sketch.