

TATE
G #429
8-15-69

MISSISSIPPI
BOARD OF WATER COMMISSIONERS
416 North State Street
Jackson, Mississippi 39201

CODED

WATER WELL DRILLERS LOG

8-15-69 date well completed Harris Bros. Tate firm name county well located


LANDOWNER: <u>David G. Tate</u>	description of formations encountered	from	to
<u>R.F.D.</u> <u>Coldwater</u> (mailing address)	<u>top soil</u>	0	20
WELL LOCATION: sec. <u>8</u> T <u>S</u> N <u>7</u> R <u>7</u> E <u>W</u> <u>1</u> miles <u>S</u> of <u>Coldwater</u> (distance) (direction) (nearest town)	<u>clay + sand</u>	20	110
WELL PURPOSE: <u>home</u> (home, irrigation, municipal, industrial)	<u>loose sand</u>	110	1-30
WELL COMPLETION DATA:			
(1) diameter (inches) <u>4"</u>			
(2) total depth (feet) <u>130</u>			
(3) static water level (feet) <u>60</u> <input checked="" type="radio"/> below <input type="radio"/> above top of ground.			
(4) casing <u>Plastic</u> , <u>116'</u> (material) (depth) <u>4"</u> if telescope see back. (size)			
(5) screen <u>1 1/4'</u> , <u>116'</u> (length) (depth to top)			
.008 <u>Plastic</u> (size) (material)			
(6) pump <u>1</u> <u>15</u> (HP) (yield gpm)			
<u>electric</u> (type power)			
(7) electric log <u>NO</u> (yes or no)			
(organization running log)			
(8) how well bottom plugged <u>with shot</u>			
DRILLERS REMARKS:			

DEC 22 1969

MISS. BD. OF
WATER COM.:

If well telescopes please sketch and show depths.

GROUND LEVEL

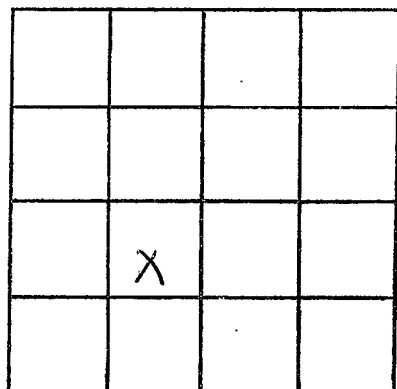

SECTION 8

Please indicate well location X.

ADDITIONAL INFORMATION

If more than one screen,
show locations of each on sketch.