

TATE
G 31
10-19-71

MISSISSIPPI
BOARD OF WATER COMMISSIONERS
416 North State Street
Jackson, Mississippi 39201

CODED

WATER WELL DRILLERS LOG

10-19-71 date well completed Bob Smith firm name Tate county well located

LANDOWNER: Carter Springblood
Andersone, Miss.
(mailing address)

description of formations encountered	from	to
top soil	0	5
red clay	5	20
red sand	20	40
red gravel	40	80
white clay	80	100
white sand	100	127

WELL LOCATION:
sec. 2 T. 5 N. R. 7 E.
5 miles WEST of POAQUILE
(distance) (direction) (nearest town)

WELL PURPOSE: None
(home, irrigation, municipal, industrial)

- WELL COMPLETION DATA:
- (1) diameter (inches) 4
 - (2) total depth (feet) 127
 - (3) static water level (feet) 130 below above top of ground.
 - (4) casing Plastic, 127
(material) (depth)
(size) if telescope see back.
 - (5) screen 20, 110
(length) (depth to top)
4, Plastic
(size) (material)
 - (6) pump 3/4, 15
(HP) (yield gpm)
Electric
(type power)
 - (7) electric log no
(yes or no)
(organization running log)
 - (8) how well bottom plugged plugged

CODED


NOV 22 1971

MISS. DEP. OF
WATER CONTROL

DRILLERS REMARKS:

If well telescopes please sketch and show depths.

GROUND LEVEL

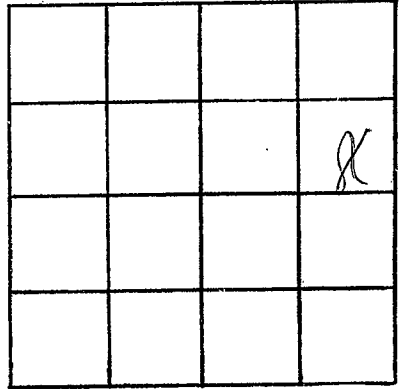

SECTION _____

Please indicate well location X.

ADDITIONAL INFORMATION

If more than one screen, show locations of each on sketch.