

TATE
G32
6-20-71

MISSISSIPPI
BOARD OF WATER COMMISSIONERS
416 North State Street
Jackson, Mississippi 39201

DEC 8 1971

CODED
WATER

WATER WELL DRILLERS LOG

6-20 1971 date well completed
Harris Bros firm name
Tate county well located

LANDOWNER: Gale McLean
Rt. 1
Senatobia
(mailing address)

description of formations encountered	from	to
top soil	0	20
red sand + clay	20	65
white clay + sand	65	125
coarse sand	125	140

WELL LOCATION:
sec. 35 T. 5 N. R. 7 E
1 miles S of New Town
(distance) (direction) (nearest town)

WELL PURPOSE: Home
(home, irrigation, municipal, industrial)

- WELL COMPLETION DATA:
- (1) diameter (inches) 4
 - (2) total depth (feet) 140
 - (3) static water level (feet) 80 ^{below} top of ground.
 - (4) casing Plastic, 133
(material) (depth)
4
(size) If telescope see back.
 - (5) screen 7, 133
(length) (depth to top)
008, Plastic
(size) (material)
 - (6) pump 3/4, 7
(HP) (yield gpm)
elec.
(type power)
 - (7) electric log no
(yes or no)


CODED

(organization running log)
(8) how well bottom plugged check
shot

DRILLERS REMARKS:

If well telescopes please sketch and show depths.

GROUND LEVEL

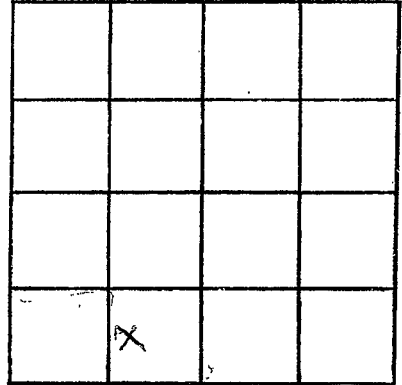

SECTION 35

Please indicate well location X.

ADDITIONAL INFORMATION

If more than one screen,
show locations of each on sketch.