

MISSISSIPPI  
BOARD OF WATER COMMISSIONERS  
416 North State Street  
Jackson, Mississippi 39201

**CODED**

MISS. BD. OF

WATER WELL DRILLERS LOG

Tate  
G 33  
7-9-71


7-9 1971 Harris Bros. Tate  
date well completed firm name county well located

LANDOWNER: <u>J. Montgomery</u>	description of formations encountered	from	to
<u>pt. 2</u> <u>Coldwater</u> (mailing address)			
<p>WELL LOCATION: sec. <u>3</u> T <u>5</u> N R <u>7</u> E <u>3</u> miles <u>W</u> of <u>Poyville</u> (distance) (direction) (nearest town)</p>	<u>top soil</u>	<u>0</u>	<u>20</u>
	<u>white clay</u>	<u>20</u>	<u>70</u>
	<u>clay &amp; sand</u>	<u>70</u>	<u>125</u>
	<u>coarse sand</u>	<u>125</u>	<u>140</u>
<p>WELL PURPOSE: <u>home</u> (home, irrigation, municipal, industrial)</p>			
<p>WELL COMPLETION DATA:</p>			
(1) diameter (inches) <u>4</u>			
(2) total depth (feet) <u>140</u>			
(3) static water level (feet) <u>80</u> <sup>below</sup> <sub>above</sub> top of ground.			
(4) casing <u>Plastic</u> , <u>133</u> (material) (depth)			
<u>4</u> if telescope see back. (size)			
(5) screen <u>7</u> , <u>133</u> (length) (depth to top)			
<u>008</u> , <u>Plastic</u> (size) (material)			
(6) pump <u>3/4</u> , <u>7</u> (HP) (yield gpm)			
<u>elec.</u> (type power)			
(7) electric log <u>no</u> (yes or no)			
<u></u> (organization running log)			
(8) how well bottom plugged <u>back</u> <u>shot</u>			
DRILLERS REMARKS:			

**CODED**

If well telescopes please sketch and show depths.

GROUND LEVEL

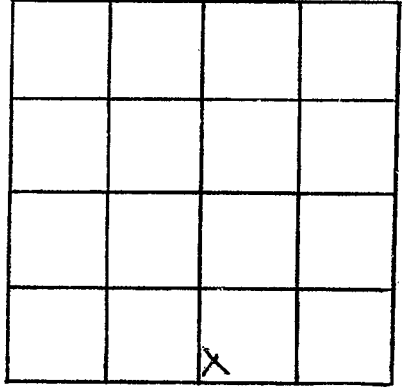

SECTION 3

Please indicate well location X.

ADDITIONAL INFORMATION

If more than one screen, show locations of each on sketch.