

MISSISSIPPI  
BOARD OF WATER COMMISSIONERS SEC 8 1971

416 North State Street  
Jackson, Mississippi 39201

WATER WELL DRILLERS LOG

**CODED**

TATE  
G34  
8-15-71

8-15 1971 Harris Bros. Tate  
date well completed firm name county well located

LANDOWNER: W.A. Wallace  
pt. 1  
Senatobia  
(mailing address)

description of formations encountered	from	to
<u>top soil</u>	<u>0</u>	<u>20</u>
<u>clay + sand</u>	<u>20</u>	<u>90</u>
<u>Coarse sand</u>	<u>90</u>	<u>100</u>

WELL LOCATION:  
sec 27 T 5 N R 7 E  
1 1/2 miles E of Senatobia  
(distance) (direction) (nearest town)

WELL PURPOSE: home  
(home, irrigation, municipal, industrial)

WELL COMPLETION DATA:

(1) diameter (inches) 4

(2) total depth (feet) 100

(3) static water level (feet) 60 <sup>below</sup> above top of ground.

(4) casing plastic 93'  
(material) (depth)

4 if telescope see back.  
(size)

(5) screen 7' 93  
(length) (depth to top)

pos plastic  
(size) (material)

(6) pump 3/4 7  
(HP) (yield gpm)

elec  
(type power)

(7) electric log no  
(yes or no)

(organization running log)


(8) how well bottom plugged back  
spot

**CODED**

DRILLERS REMARKS:

If well telescopes please sketch and show depths.

GROUND LEVEL

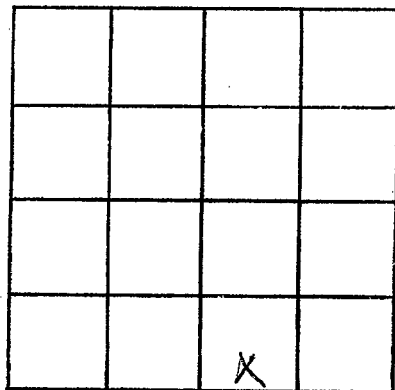

SECTION 27

Please indicate well location X.

ADDITIONAL INFORMATION

If more than one screen,  
show locations of each on sketch.