

TATE
G 35
10-5-71

MISSISSIPPI
BOARD OF WATER COMMISSIONERS DEC 9 1971
416 North State Street
Jackson, Mississippi 39201

WATER WELL DRILLERS LOG

MISS
CODED

10-5 1971 Harris Bros. Tate
date well completed firm name county well located

LANDOWNER: Clarence Wilborn

Description of formations encountered

from

to

Rt. 1
Coldwater
(mailing address)

top soil	0	20
gravel + sand	20	65
clay + sand	65	155
Coarse sand	155	180

WELL LOCATION:

sec. 8 T. 5 N R. 7 E
1 miles E of Coldwater
(distance) (direction) (nearest town)

WELL PURPOSE: home
(home, irrigation, municipal, industrial)

WELL COMPLETION DATA:

- diameter (inches) 4
- total depth (feet) 180
- static water level (feet) 20 ^{below} top of ground
- casing Plastic, 166 (material) (depth)
4 (size) if telescope see back.
- screen 14' (length) 166' (depth to top)
000 Plastic (size) (material)
- pump 3/4 (HP) 10 (yield gpm)
elec. (type power)
- electric log No (yes or no)

(organization running log)


- (8) how well bottom plugged back

DRILLERS REMARKS:

CODED

If well telescopes please sketch and show depths.

GROUND LEVEL

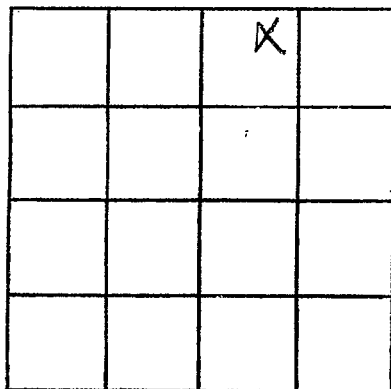

SECTION 8

Please indicate well location X.

ADDITIONAL INFORMATION

If more than one screen,
show locations of each on sketch.