

MISSISSIPPI
BOARD OF WATER COMMISSIONERS
416 North State Street
Jackson, Mississippi 39201

DEC 2 1971
CODED

WATER WELL DRILLERS LOG

TATE
~~G36~~
10-4-71


10-4 1971 Harris Bros. Tate
date well completed firm name county well located

LANDOWNER:	Description of formations encountered	from	to
<u>Otis Johnson</u>	<u>top soil</u>	<u>0</u>	<u>20</u>
<u>Rt. 2</u>	<u>gravel</u>	<u>20</u>	<u>65</u>
<u>Coldwater</u> (mailing address)	<u>clayt sand</u>	<u>65</u>	<u>150</u>
<u>1</u> miles <u>E</u> of <u>Coldwater</u> (distance) (direction) (nearest town)	<u>coarse sand</u>	<u>150</u>	<u>170</u>
<p>WELL LOCATION: sec. <u>5</u> T <u>5</u> N R <u>7</u> E <u>1</u> miles <u>E</u> of <u>Coldwater</u> (distance) (direction) (nearest town)</p>			
<p>WELL PURPOSE: <u>home</u> (home, irrigation, municipal, industrial)</p>			
<p>WELL COMPLETION DATA:</p>			
(1) diameter (inches) <u>4</u>			
(2) total depth (feet) <u>170</u>			
(3) static water level (feet) <u>100</u> <u>below</u> above top of ground			
(4) casing <u>plastic</u> , <u>156</u> (material) (depth)			
<u>4</u> if telescope see back. (size)			
(5) screen <u>14'</u> , <u>156</u> (length) (depth to top)			
<u>208</u> , <u>plastic</u> (size) (material)			
(6) pump <u>3/4</u> <u>10</u> (HP) (yield gpm)			
<u>elec.</u> (type power)			
(7) electric log <u>no</u> (yes or no)			
(organization running log)			
(8) how well bottom plugged <u>back</u> <u>shot</u>			
DRILLERS REMARKS:			

CODED

If well telescopes please sketch and show depths.

GROUND LEVEL

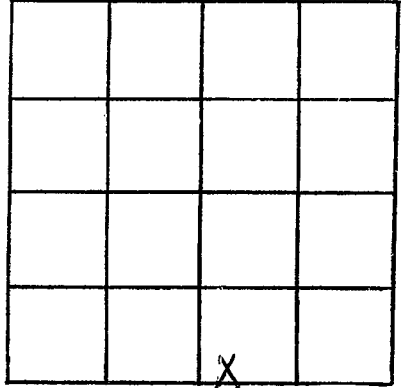

SECTION 5

Please indicate well location X.

ADDITIONAL INFORMATION

If more than one screen,
show locations of each on sketch.